

Name Paul Ford

Service No. 51

Address 11 Sunny Knoll Terrace

11 Sunny Knoll Terrace

Location

Kind of Pipe

Size 6"

Size of Main 8"

Repair—Renewal—New Service Sibley #1090

Location AUG 5 1968

Date	Material	Amount	Total	Date		Amount
9-2-58	Labor	5.74		6-26-68	Deposit	22 46
	10% O.H.	.57	6.31			
	22' 6" Transite pipe @.70		15.40			
	1 hr. Trucking @.75		.75			
	(Bill when connected)		22.46		OUTSIDE	
7-2-68	31' 6" Transite pipe			11/29/77	Labor	411 04
	10' 4" Cast Iron pipe				1 6" x 8" Style 360° Repair	
					Clamp	34 43
					1 22½° Bend	9 70
					4 Hrs. Trucking	12 00
					6 Hrs. Backhoe	39 00
						506 17
	Labor					

TOWN OF LEXINGTON—DEPT. OF PUBLIC WORKS

SEWER DIVISION

DATE.....

NO.....


The undersigned applies for the construction of a particular sewer connecting No.....
 Street and hereby agrees to comply with the Rules and Regulations governing the construction and use of Particular
 Sewers, as now or at any future time established by the Board of Selectmen.

Am't of estimate \$.....

Am't Paid \$.....

..... Owner

Sketch of Service Here //

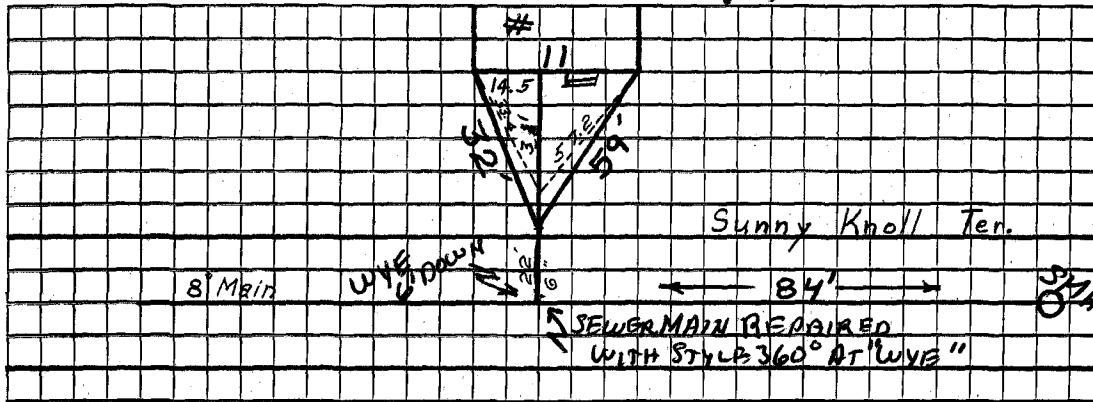

Connection made in..... Street.

Work completed.....19..

Remarks: