

Name Steven Hastings

Service No. 69 17

Address ^P 15 ~~27~~ Sunny Knoll Terrace NO - NUMBER 17

~~15~~ Sunny Knoll Terrace

Location

Kind of Pipe

Size 6"

Size of Main 8"

Repair—Renewal—New Service Valeri #678

Location SEP 5 1967

Date	Material	Amount	Total	Date	Amount
9-2-58	Labor	5.74		6-20-68	18 9/16
	10% O.H.	.57	6.31		
	17' 6" Transite pipe @.70		11.90		
	1 hr. Trucking @.75		.75		
	(Bill when connected)		18.96		
6-20-67	30' 6" Transite pipe				
	10' 4" Cast Iron Pipe				
	Labor				

TOWN OF LEXINGTON—DEPT. OF PUBLIC WORKS

SEWER DIVISION

DATE.....

NO.


The undersigned applies for the construction of a particular sewer connecting No.....
 Street and hereby agrees to comply with the Rules and Regulations governing the construction and use of Particular
 Sewers, as now or at any future time established by the Board of Selectmen.

Am't of estimate \$.....

Am't Paid \$.....

..... Owner

Sketch of Service Here ~~17~~ 15

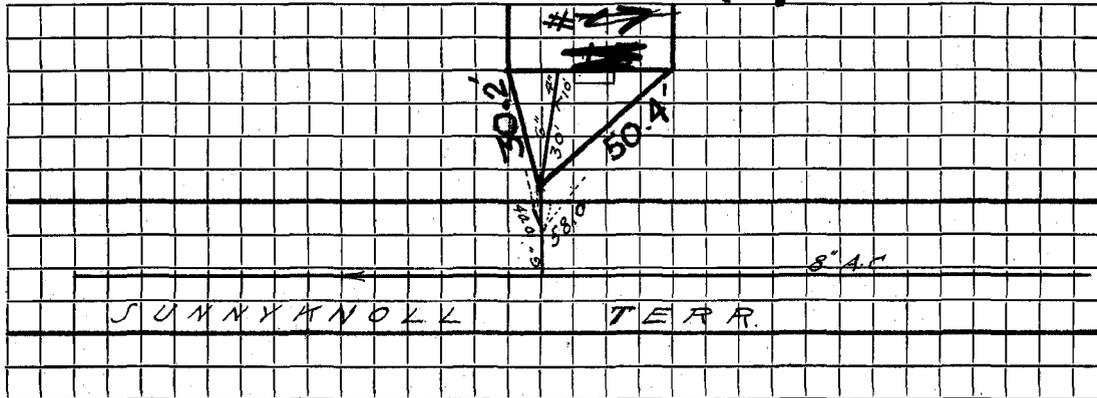

Connection made in..... Street.

Work completed.....19..

Remarks: