

Name S & A Realty Trust (Ralph Hall)

Service No. 63

Address 18 Sunny Knoll Terrace

18 Sunny Knoll Terrace

Location

Kind of Pipe

Size 6"

Size of Main 8"

~~REPAIR/RENEWAL~~ - New Service DeFlice Bros. #2296

Location APR 8 1974

Date	Material	Amount	Total	Date	Amount
9-2-58	Labor	5.74		7-16-73	21 7/8
	10% O.H.	.57	6.31		
	21' 6" Transite Pipe @.70		14.70		
	1 hr. Trucking @.75		.75		
	(Bill when connected)		21.76		
7/19/73	35' 6" Transite				
	10' 4" Cast Iron				
	Labor				

TOWN OF LEXINGTON—DEPT. OF PUBLIC WORKS
SEWER DIVISION

DATE.....

NO.


The undersigned applies for the construction of a particular sewer connecting No.....
 Street and hereby agrees to comply with the Rules and Regulations governing the construction and use of Particular
 Sewers, as now or at any future time established by the Board of Selectmen.

Am't of estimate \$.....

Am't Paid \$.....

..... Owner

Sketch of Service Here **18**

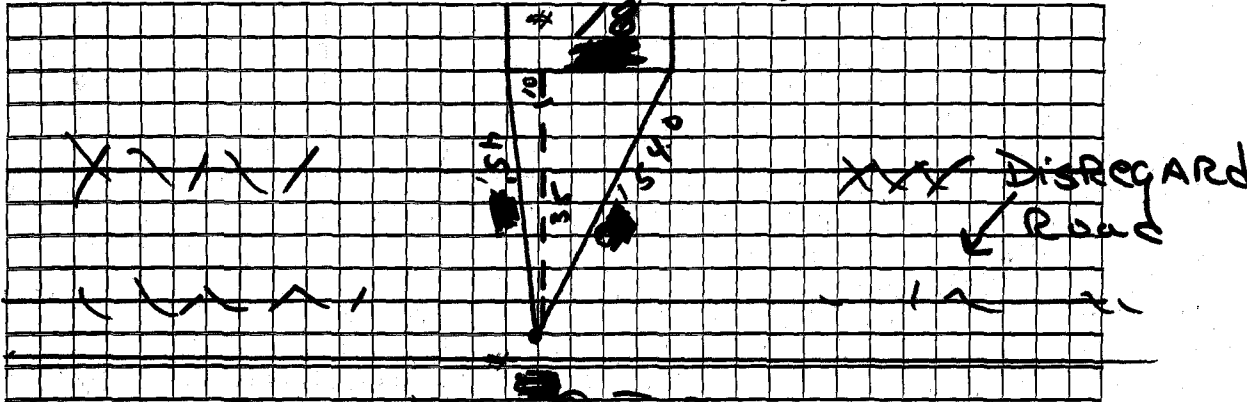

Sunnyknoll ~~P~~ Ter.

Connection made in Street Work completed 19..

Remarks: