


DATE 6-10-82

TOWN OF LEXINGTON — BOARD OF PUBLIC WORKS
SEWER DIVISION

Sketch of Service Here **3**

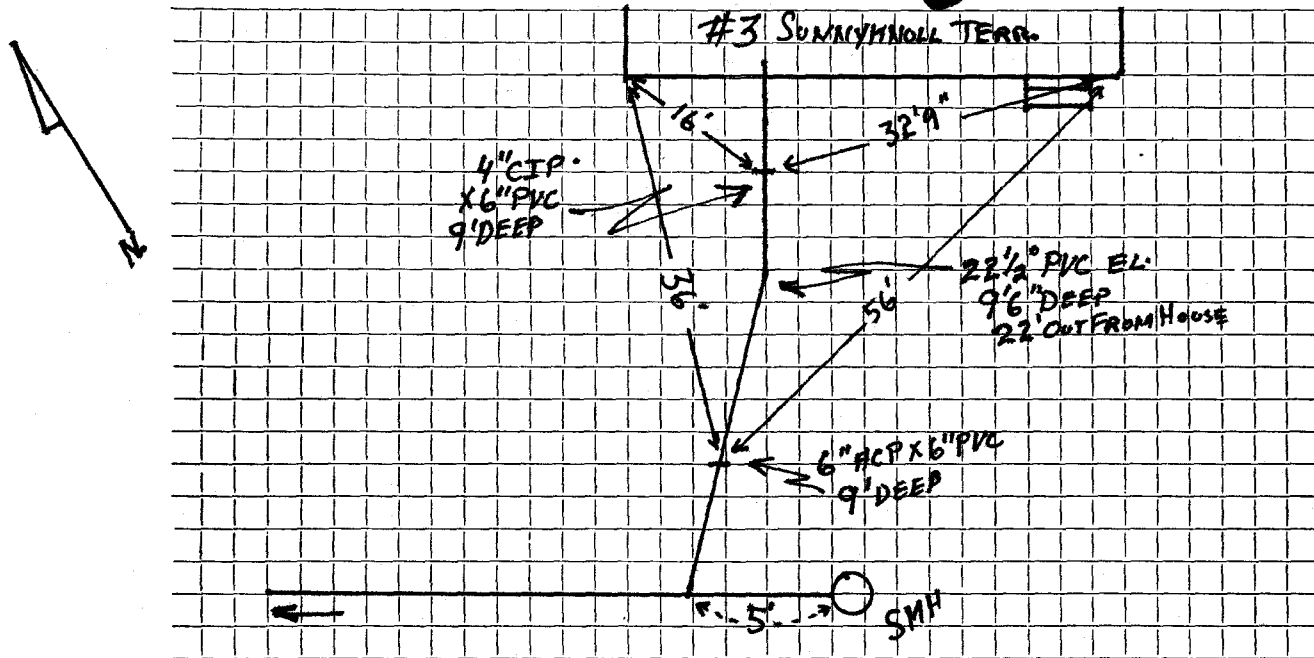

Connection made in SONNYMOLL TERR. Street. Work completed

Remarks:
.....
.....