

Name

Service No.

Address #8 SUNNY KNOLL AVE

8 Sunny Knoll Ave.

Location

Kind of Pipe AC

Size 6"

Size of Main 8"

Repair—Renewal—New Service

Location


Date	Material	Amount	Total	Date	Amount
12-4-74	52' 6" AC	@ \$9 00	\$468 00		

DATE _____

TOWN OF LEXINGTON — BOARD OF PUBLIC WORKS

SEWER DIVISION

Sketch of Service Here **8**

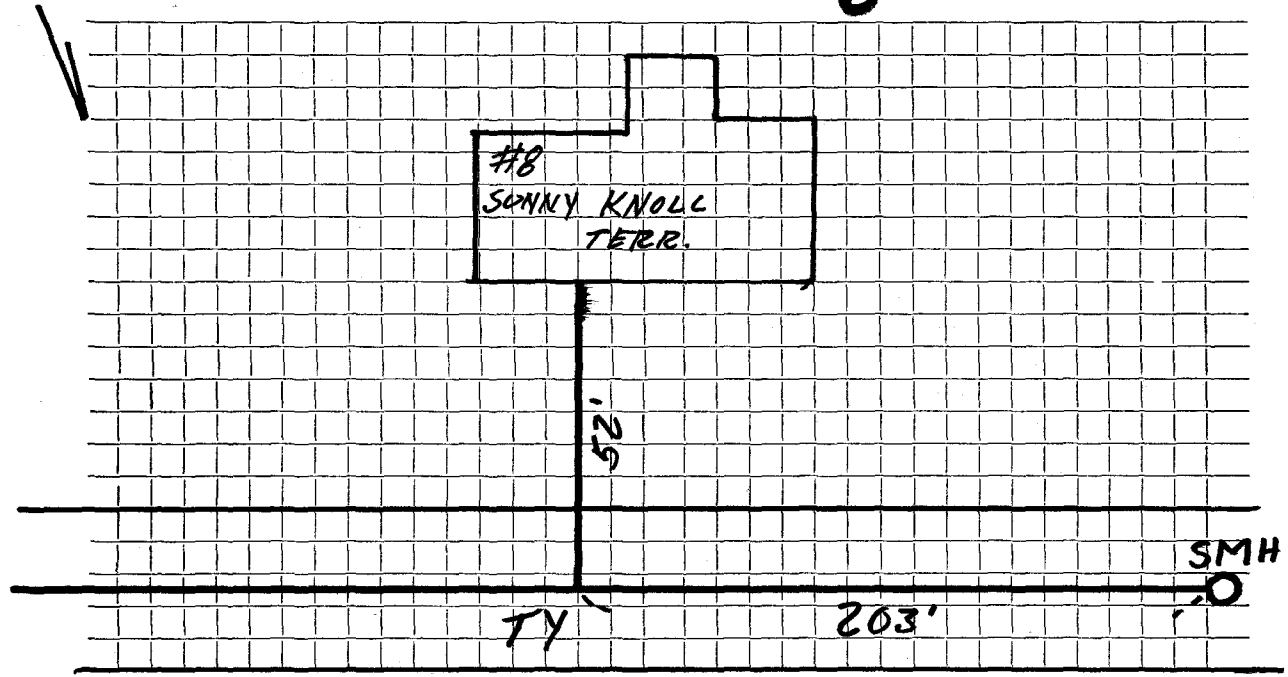

Connection made in Street. Work completed

Remarks:
.....
.....