

Name William E. Silvio

Service No. 22

Address 9 Sunny Knoll Terrace

9 Sunny Knoll Terrace

Location

Kind of Pipe

Size 6"

Size of Main 8"

Repair—Renewal—New Service W.O.#4414 Sibley#523

Location JAN 22 1968

Date	Material	Amount	Total	Date	Amount
5-15-67	59' 6" Transite pipe			4-20-67	Deposit 250 00
	10' 4" Cast Iron pipe			1-22-68	Retard 70 33
4-25-67	Labor 55.60			12-4-74	179 68
5-10-67	" 10.94			236' 6" Transite	
5-15-67	" 10.94			1 6" X 8" Wye	
5-15-67	" 12.03	89 51			
	10% O.H.	8 95	98 46		
	35" 6" Transite pipe @.88		30 80		
	3 collars @1.09		3 27		
	1 Bag Cement @1.55		1 55		
	2 ton hot top @5.80		11 60		
	5½ Hrs. Trucking @3.00		16 50		
	1 Hr. Shovel @6.50		6 50		
	½ Hr. Loader @4.00		2 00		
	1½ Compressor @5.00		7 50		
	½ Hr. Roller @3.00		1 50		
			179 68		


DATE \_\_\_\_\_

TOWN OF LEXINGTON — BOARD OF PUBLIC WORKS

SEWER DIVISION

Sketch of Service Here

9

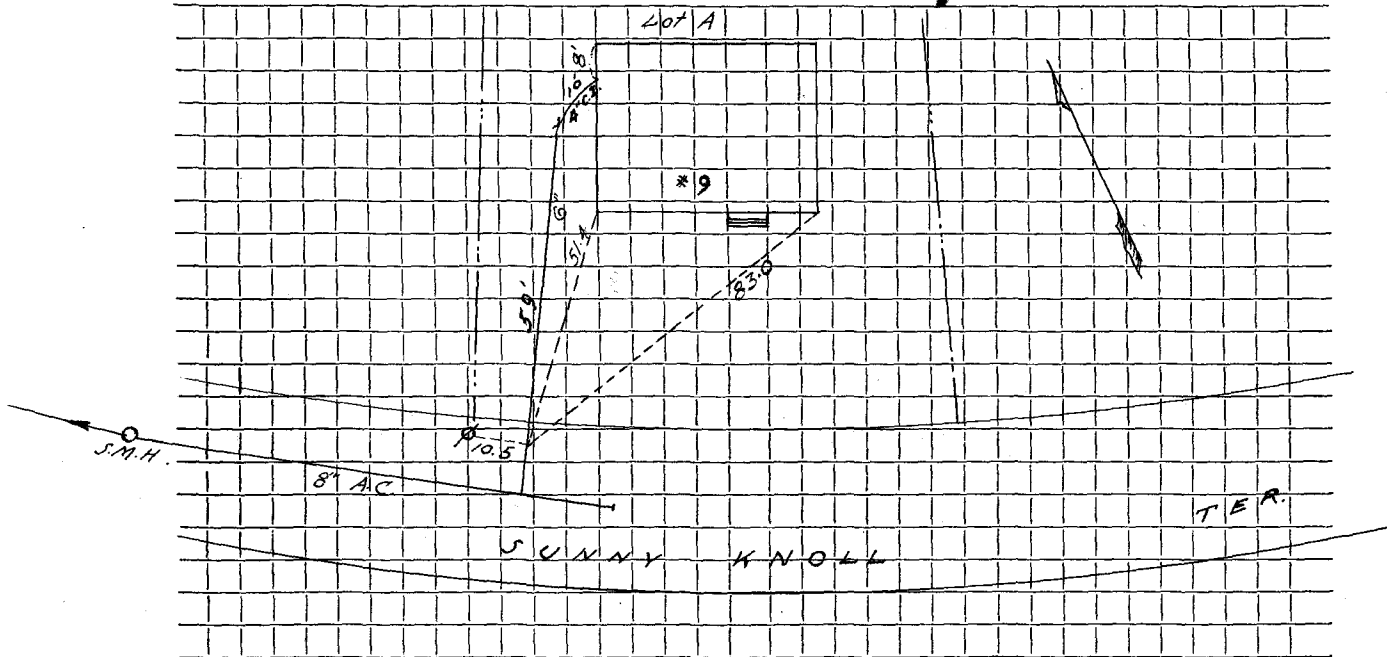

Connection made in ..... Street. Work completed .....

Remarks: .....

.....

.....