




DATE \_\_\_\_\_

TOWN OF LEXINGTON — BOARD OF PUBLIC WORKS

SEWER DIVISION

Sketch of Service Here **4**

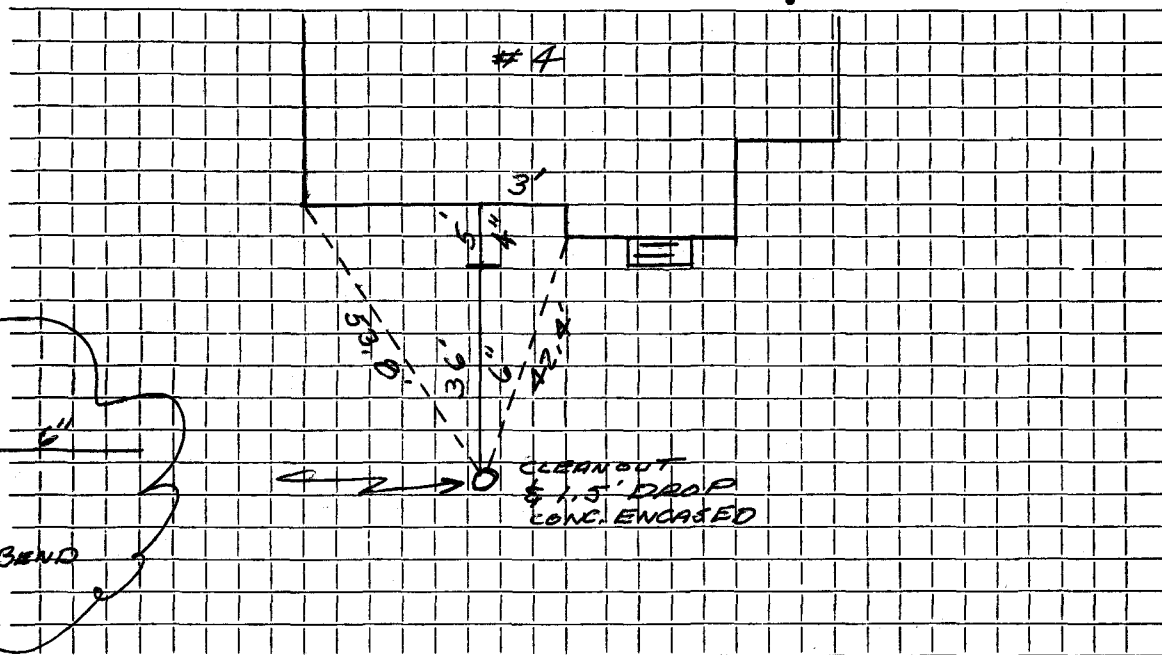

Connection made in SUNSET RIDGE Street. Work completed .....

Remarks: NO OUTSIDE TIES .....

Subdivision .....