




DATE AUGUST 14, 1997

TOWN OF LEXINGTON — BOARD OF PUBLIC WORKS  
SEWER DIVISION

Sketch of Service Here **5**

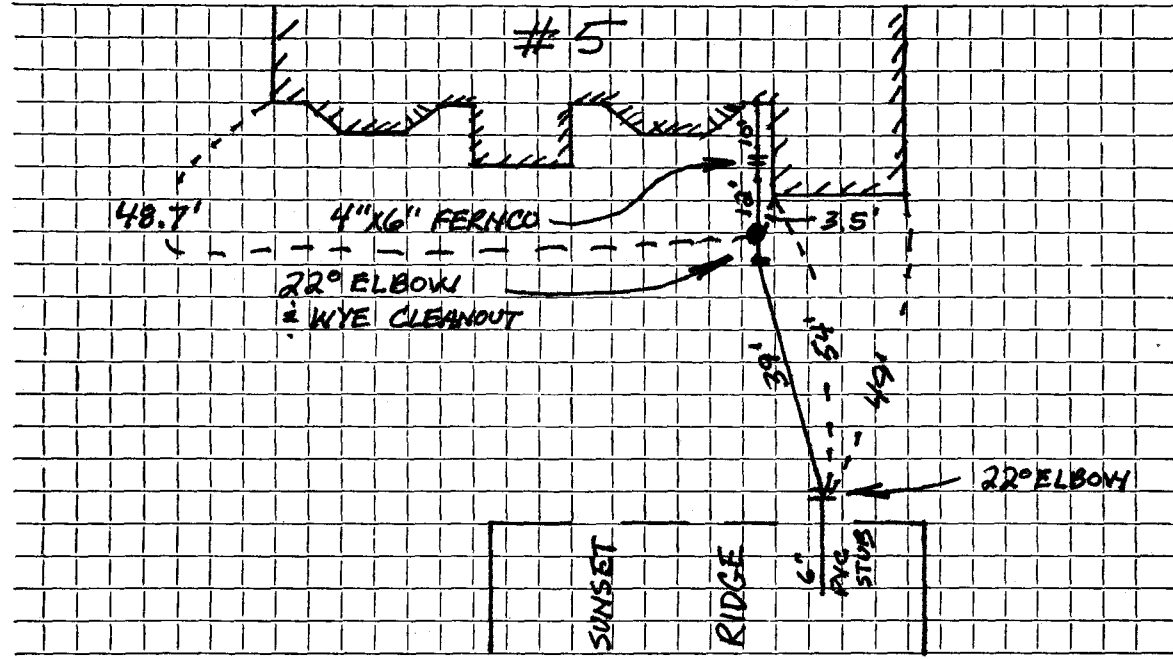

Connection made in SUNSET RIDGE Street. Work completed .....

Remarks: .....