

Name Waverley Construction Co.Service No. 29 104/3Address 10 Sutherland RoadLexington, Mass.Location 10 Sutherland Road

Kind of Pipe

Size 6"Size of Main 8"~~Repair~~ ~~Renewal~~ New ServiceCom. 12 2 '46

Location

Date	Material	Amount	Total	Date		Amount
Oct. 28, '46	Labor	8 82		Oct. 22 '46	Hydrated	60 00
29	"	21 87		Dec. 10 '46	Card	57
30	"	<u>7 60</u>	38 29			60 57
	10% Overhead		<u>3 83</u>			
	38' - 6" Pipe		8 89			
	1 - 6" Elbow		1 28			
	Joint Compound		2 28			
	Compressor 3 hrs. @1.75		5 25			
	Trucking 1 hr. @.75		<u>75</u>			
			<u>60 57</u>			
	Labor					

TOWN OF LEXINGTON—DEPT. OF PUBLIC WORKS

SEWER DIVISION

DATE .....


NO. ....

The undersigned applies for the construction of a particular sewer connecting No. .... Street and hereby agrees to comply with the Rules and Regulations governing the construction and use of Particular Sewers, as now or at any future time established by the Board of Selectmen.

Am't of estimate \$.....

Am't Paid \$.....

..... Owner

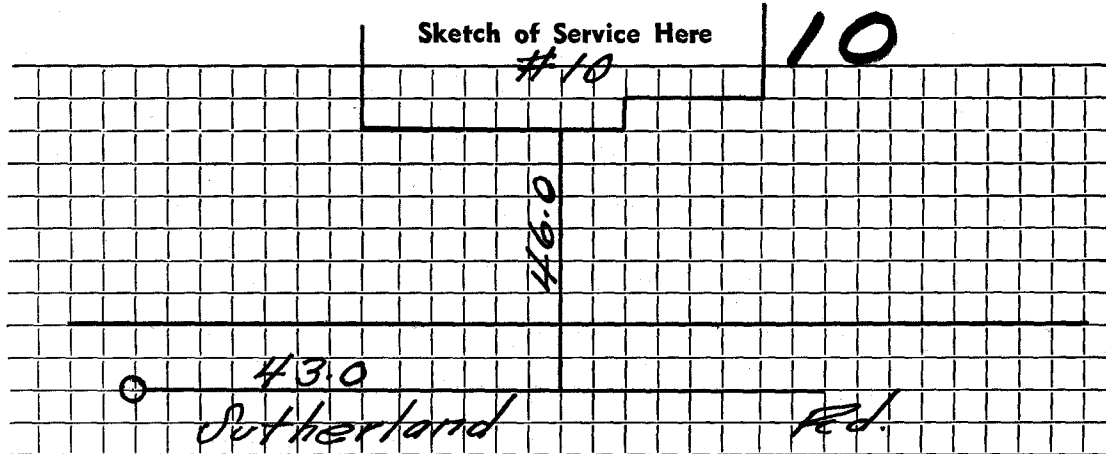

Connection made in ..... Street.

Work completed ..... 19..

Remarks: