

Name Lexington Homes, Inc.

Service No. 18 934

Address 57 Bedford Street, Lexington, Mass.

15 Sutherland Road

Location: 15 Sutherland Road

Kind of Pipe

Size 6"

Size of Main 8"

Repair—Renewal—New Service

Location

Date 1941	Material	Amount	Total	Date	Amount
Sept. 3	4 hrs. @ 50¢	2 00		August 27, 1941 Deposited	35 00
<i>from 9/14/41.</i>	31 " @ 60¢	18 60		September 25, 1941 Paid	5 60
	16½ " @ 65¢	10 73	31 33	Sept. 27, 1941 Paid	4 16
	10% Overhead		3 13		44.76
	40' 6" Sewer Pipe @ 16¢		6 40		
	Jointing compound		2 40		
	Trucking - 2 hrs. @ 75¢		1 50		
			44 76		
				9/18/41 Bill sent.	
	Labor				

Hadley Press, Inc., Lexington

**TOWN OF LEXINGTON—BOARD OF PUBLIC WORKS**  
**SEWER DIVISION**

DATE August 21, 1944


NO. \_\_\_\_\_

The undersigned applies for the construction of a particular sewer connecting No. 15 Sutherland Rd. Street and hereby agrees to comply with the Rules and Regulations governing the construction and use of Particular (Lot #3) Sewers, as now or at any future time established by the Board of Selectmen.

Am't. of Estimate \$ 35.00

Am't. Paid \$ \_\_\_\_\_

Lexington Homes, Inc. Owner by  
W. F. Hays, Jr. Pres.

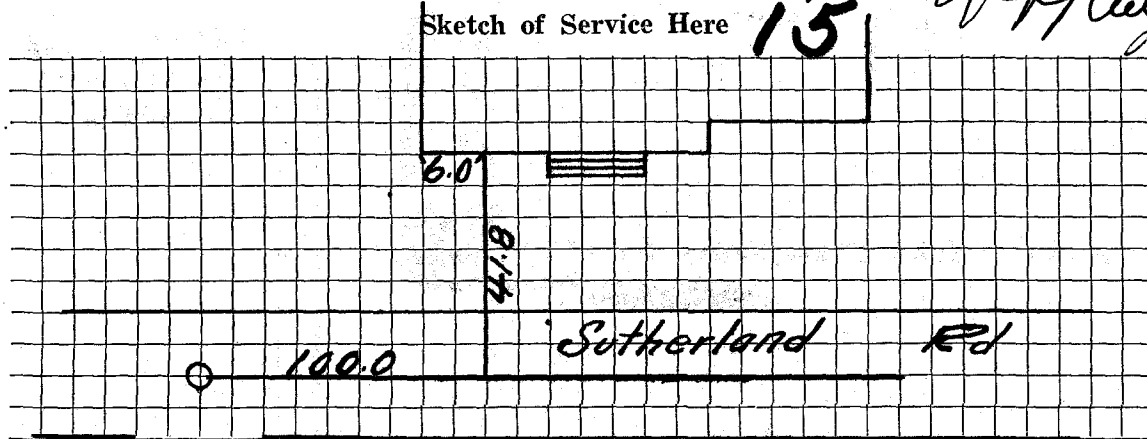

Connection made in Remarks:	<u>Aerial St.</u>	Street.	Work completed _____ 19
--------------------------------	-------------------	---------	-------------------------