

Name

Service No.

Address 16 SUTHERLAND RD.

16 Sutherland Road

Location

Kind of Pipe

Size 6"

Size of Main 8"


Repair—Renewal—New Service

Location

Date	Material	Amount	Total	Date	Amount
11-30-66	4" CI SEWER PIPE				
10-31-85	1 8"x6" PVC TEE				
	2' 8" PVC PIPE				
	2 8"x8" CLAY TO PVC FERNCO				RENEWAL W.O.# 1426
	1 4"x6" CI TO PVC FERNCO			10/31/85	23'9" 6" PVC Pipe
	1 90° 6" PVC ELBOW				1 8"x6" PVC Tee
	23'9" 6" PVC PIPE				2' 8" PVC pipe
					2 8"x8" Clay to PVC Fernco
					1 90° 6" PVC Elbow
					1 4"x6" DI to PVC Fernco
					8 Yards gravel

TOWN OF LEXINGTON — BOARD OF PUBLIC WORKS
SEWER DIVISION

Sketch of Service Here **16**

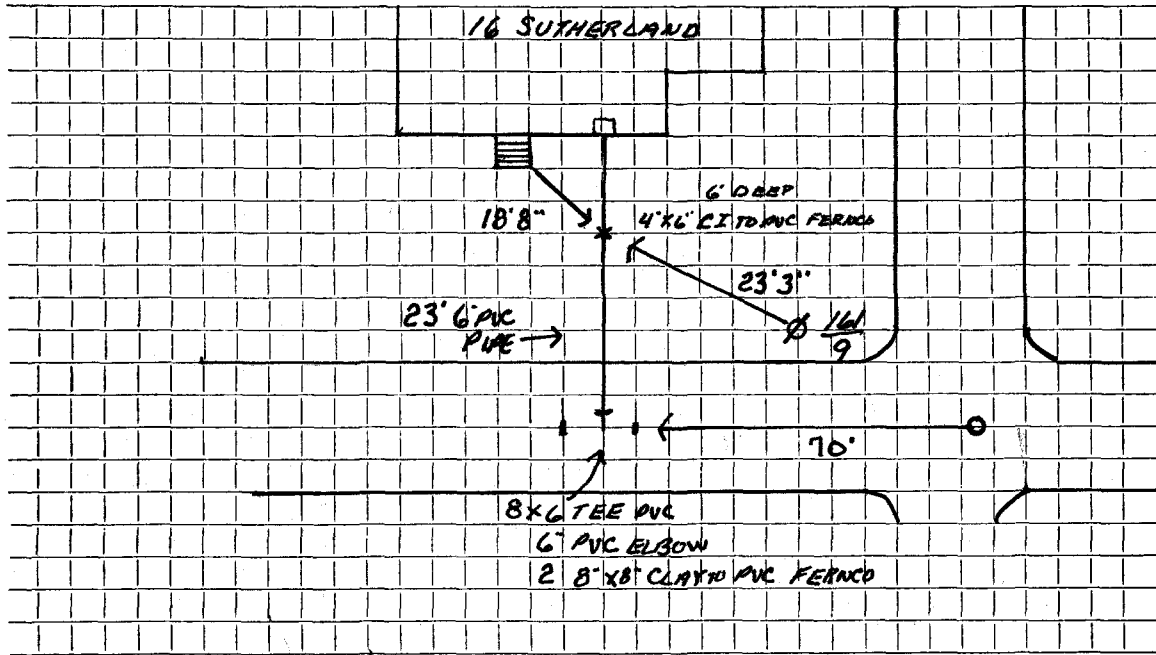

Connection made in Street. Work completed

Remarks:
.....
.....