

Name Waverley-Construction Co

Service No. 30 1046

Address 7 Sutherland Road

Lexington, Mass.

Location 7 Sutherland Road

Kind of Pipe

Size 6"

Size of Main 8"

~~Repair & Renewal~~ New Service

Cem 12 2 '46

Location

| Date | Material | Amount | Total | Date | Amount |
|--------------|---------------------------|--------|--------------|-------------|--------------------|
| Oct. 29, '46 | Labor | 19 62 | | Oct. 22 '46 | Deposited 60 00 |
| 30 | " | 29 40 | 49 02 | Dec. 10 '46 | Cash 4 71 |
| | 10% Overhead | | 4 90 | | Credit Refund 2 07 |
| | 36' - 6" Sewer Pipe @.234 | | 8 42 | | 71 78 |
| | 1 - 6" Elbow | | 1 28 | | |
| | Joint Compound | | 2 16 | | |
| | Compressor 3 hrs. @1.75 | | 5 25 | | |
| | Trucking 1 hr. @.75 | | 75 | | |
| | | | <u>71 78</u> | | |
| | Labor | | | | |

TOWN OF LEXINGTON—DEPT. OF PUBLIC WORKS

SEWER DIVISION

DATE


NO.

The undersigned applies for the construction of a particular sewer connecting No. Street and hereby agrees to comply with the Rules and Regulations governing the construction and use of Particular Sewers, as now or at any future time established by the Board of Selectmen.

Am't of estimate \$

Am't Paid \$

..... Owner

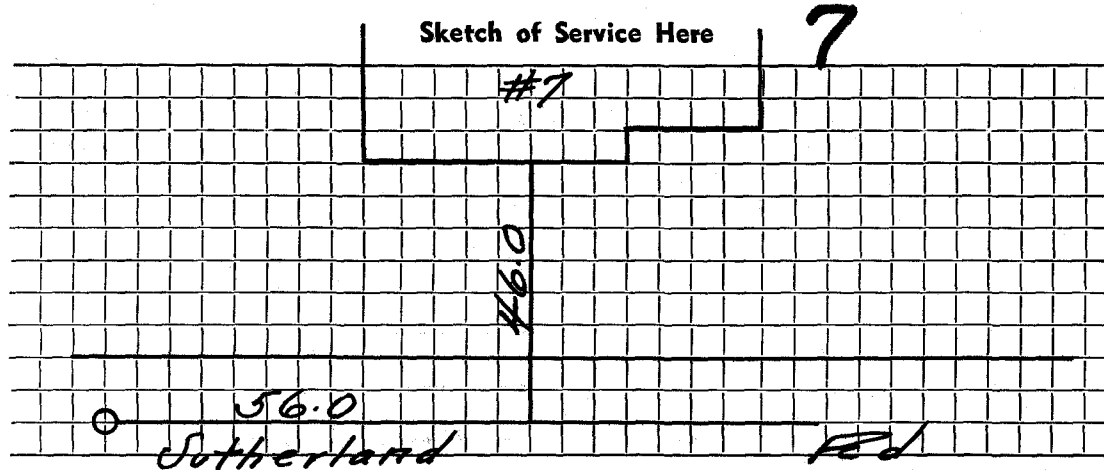

Connection made in Street.

Work completed 19..

Remarks: