

Name Waverley Construction Co.Service No. 28 1042Address 8 Sutherland RoadLexington, Mass.Location 8 Sutherland Road

Kind of Pipe

Size 6"Size of Main 8"~~Repair~~ ~~Renewal~~ New ServiceCom. 12-2-46

Location

Date	Material	Amount	Total	Date		Amount
Nov. 5, '46	Labor	31 95		Oct. 22 '46	Deposited	60 00
6	"	10 00		Dec. 10 '46	Paid	12 05
14	"	<u>11 40</u>	53 35			72 05
	10% Overhead		5 34			
	36' - 6" Sewer Pipe @ .234		8 42			
	1 - 6" Elbow		1 28		Bell sent 12-5-46	
	Joint Compound		2 16			
	Trucking 2 hrs. @ .75		<u>1 50</u>			
			72 05			
	Labor					

TOWN OF LEXINGTON—DEPT. OF PUBLIC WORKS
SEWER DIVISION

DATE


NO.

The undersigned applies for the construction of a particular sewer connecting No.
Street and hereby agrees to comply with the Rules and Regulations governing the construction and use of Particular
Sewers, as now or at any future time established by the Board of Selectmen.

Am't of estimate \$.

Am't Paid \$.

..... Owner

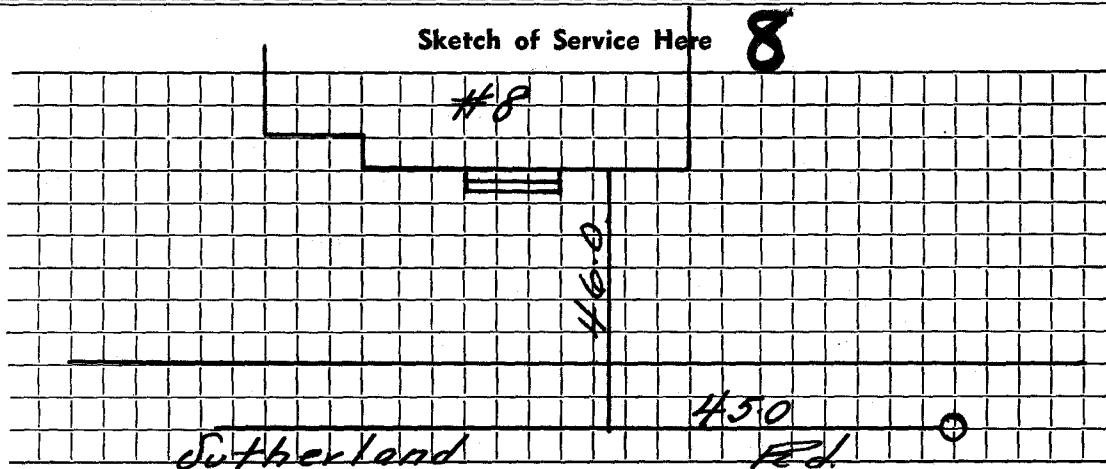

Connection made in Street.

Work completed 19..

Remarks: