

Name **Howard E. Wolff**

Service No. 121

Address **11 Suzanne Rd.**

11 Suzanne Road

Location

Kind of Pipe

Size **6"**

Size of Main **8"**

Repair—Renewal—New Service **Valeri Const. #2348**

Location **APR 8 1974**


Date		Material	Amount		Total	Date		Amount	
9-21	73	20' 6" A.C.	180	00		9-24-73	Deposit		180 00
9-26-	73	119' - 6" ACP							
		4' - 4" CI							

DATE _____

TOWN OF LEXINGTON — BOARD OF PUBLIC WORKS

SEWER DIVISION

Sketch of Service Here

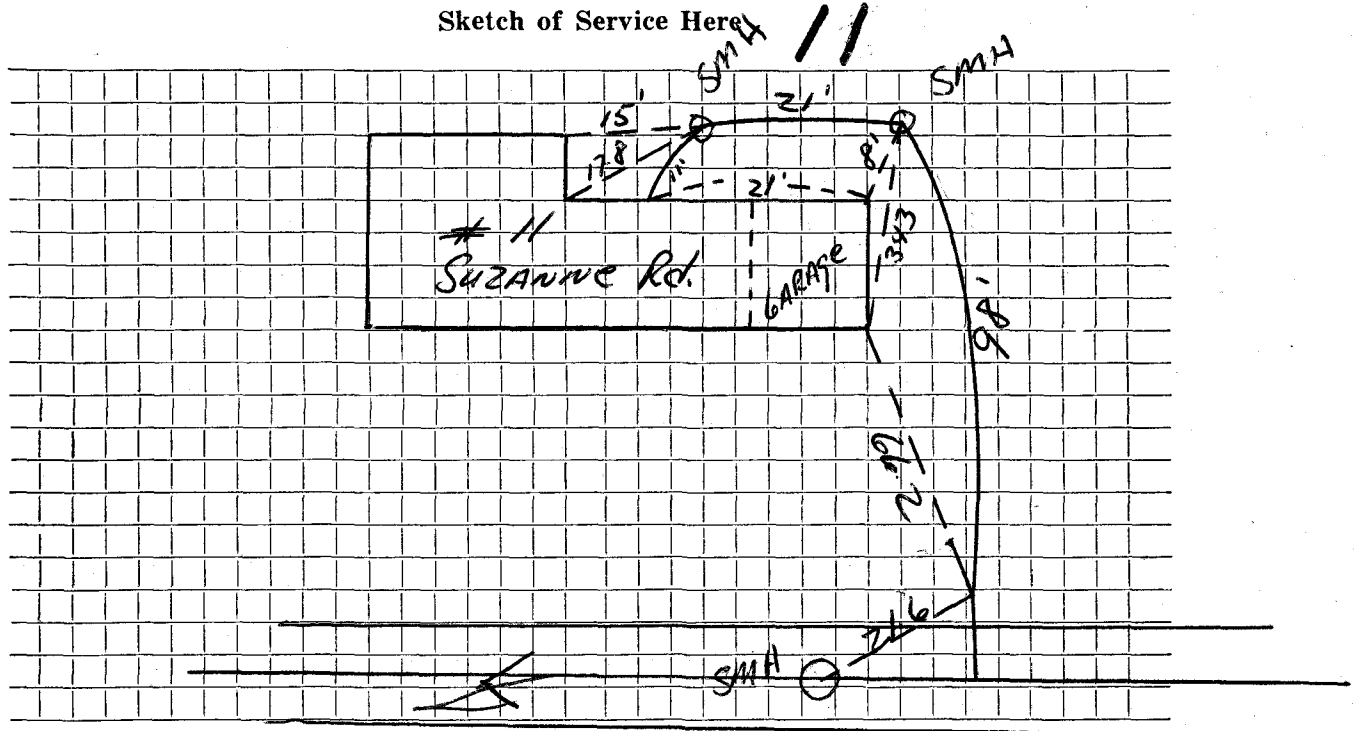

Connection made in Street. Work completed

Remarks:
.....
.....