

Name Noam Chomsky

Service No. 126

Address 15 SUZANNE RD.

15 Suzanne Road

Location

Kind of Pipe A.C.

Size 6"

Size of Main 8"

Repair—Renewal—New Service Valeri #2352

Location NOV 19 1973

Date	Material	Amount	Total	Date	Amount	
7/24/73	15.0' - 6" A.C.P. @ 9.00	\$135.00		9-27-73	Deposit	135.00
9/27/73	119' 6" Transite pipe					
	10' 4" Cast Iron pipe					

Invoice No.

DATE

Name

TOWN OF LEXINGTON — BOARD OF PUBLIC WORKS

Address

SEWER DIVISION

Size of Pipe

Size

Kind of Pipe

Location

Sketch of Service Here

15

Repair—Renewal—New Service

Amount

Date


Total

Amount

Material

SMH

Date

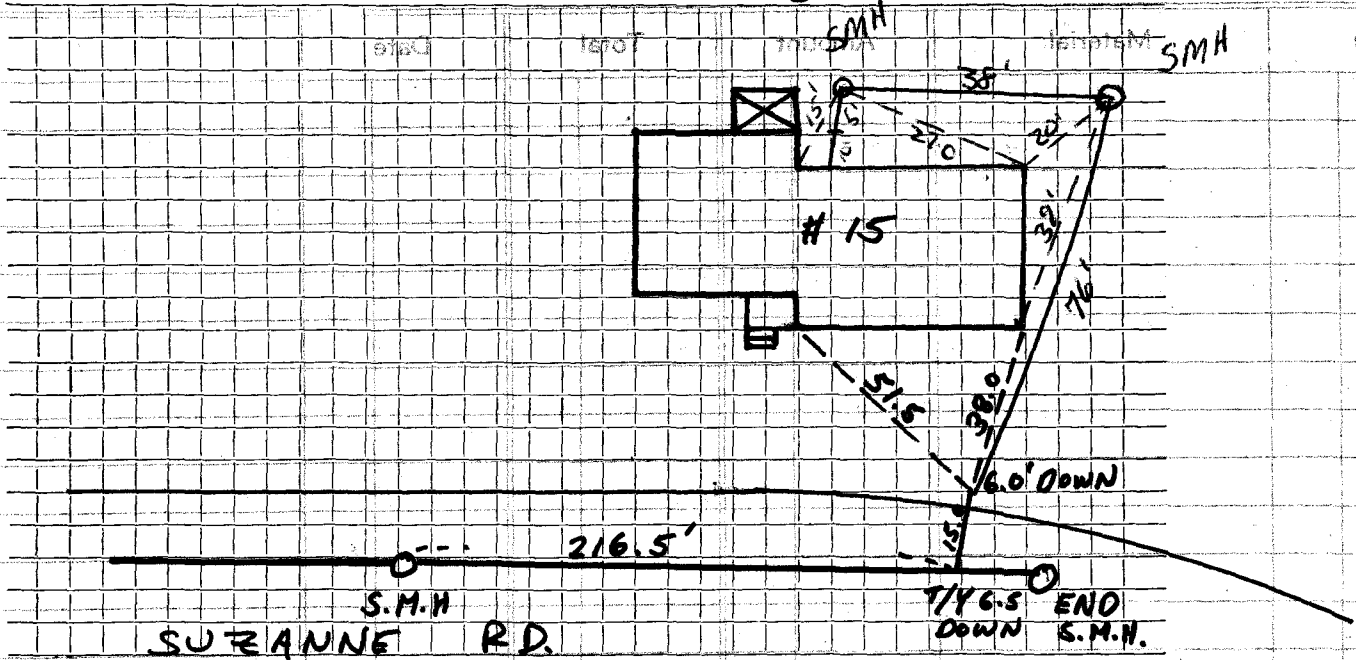

Connection made in Street. Work completed

Remarks:

.....

.....