


DATE _____

TOWN OF LEXINGTON — BOARD OF PUBLIC WORKS
SEWER DIVISION

Sketch of Service Here

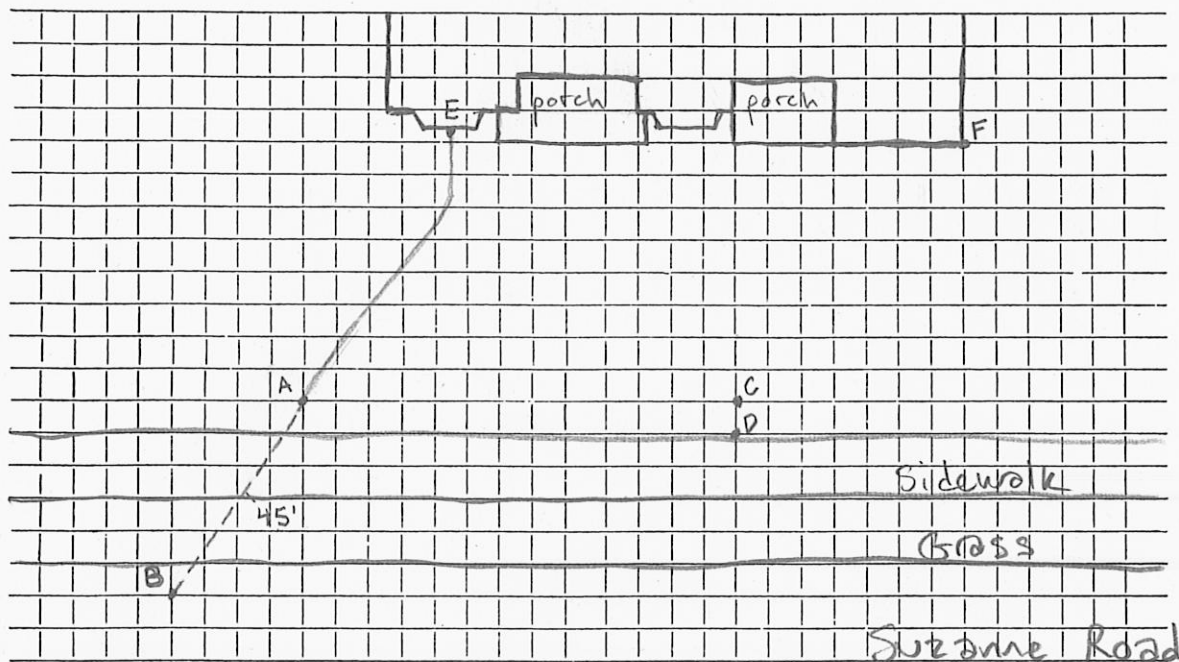

Connection made in ... Suzanne ... Street. Work completed

Remarks: ... A = Fernco, ... B = SMH, ... AB = 45'

... Bedded in Stone