


DATE 11/12/19

TOWN OF LEXINGTON — BOARD OF PUBLIC WORKS
SEWER DIVISION

Sketch of Service Here

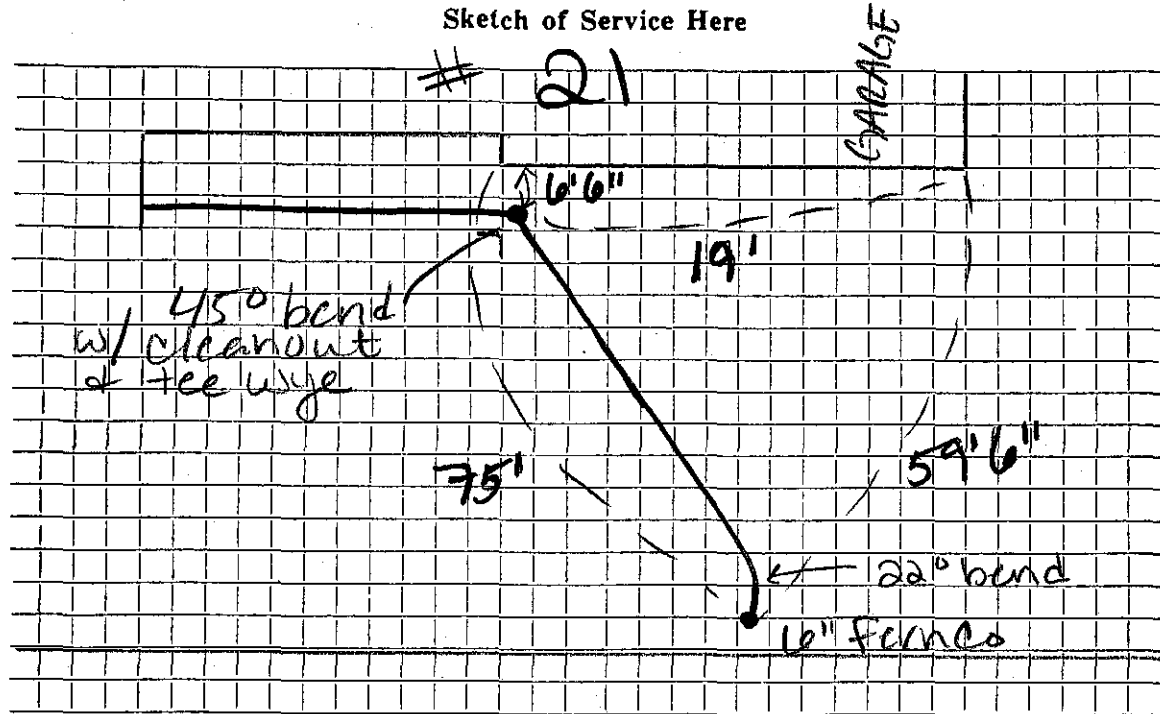

Connection made in ... Suzanne Rd Street. Work completed

Remarks:

.....

.....