


DATE _____

TOWN OF LEXINGTON — BOARD OF PUBLIC WORKS

SEWER DIVISION

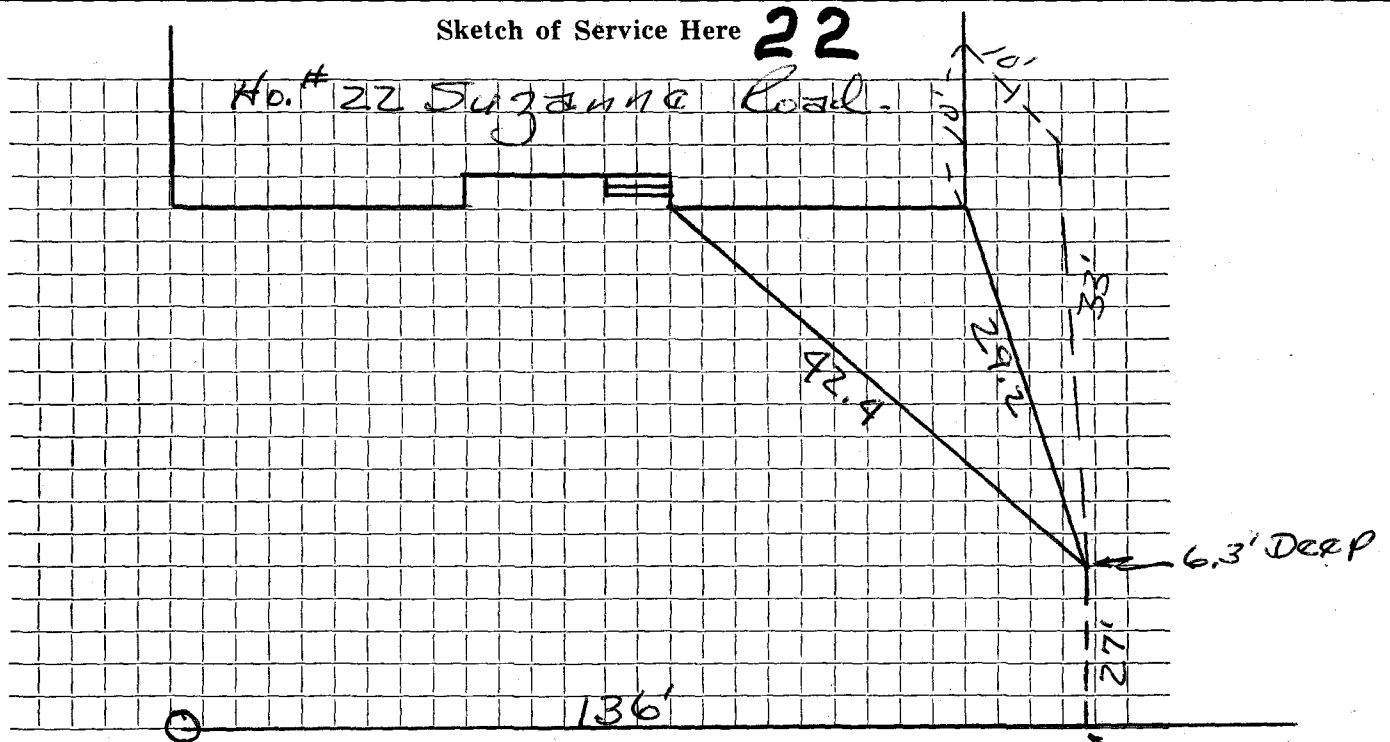

Connection made in S.M.H. Street. Work completed Tee. w/ 4" 3' Ch. m.

Remarks:

.....

.....