

Name Shepard M. Arkin

Service No. 180

Address 24 Suzanne Road

24 Suzanne Road

Location

Kind of Pipe

A.C.

Size

6"

Size of Main 8"

Repair—Renewal—New Service

Valeri Const. #2434

Location

APR 8 1974


Date	Material	Amount	Total	Date	Amount	
11/14/ 73	25' @ \$9.00	\$225.00		11-21-73	Deposit	335.00
12-11- 73	48' - 6" ACP					
	10' - 4" CI					

DATE _____

TOWN OF LEXINGTON — BOARD OF PUBLIC WORKS

SEWER DIVISION

Sketch of Service Here **24**

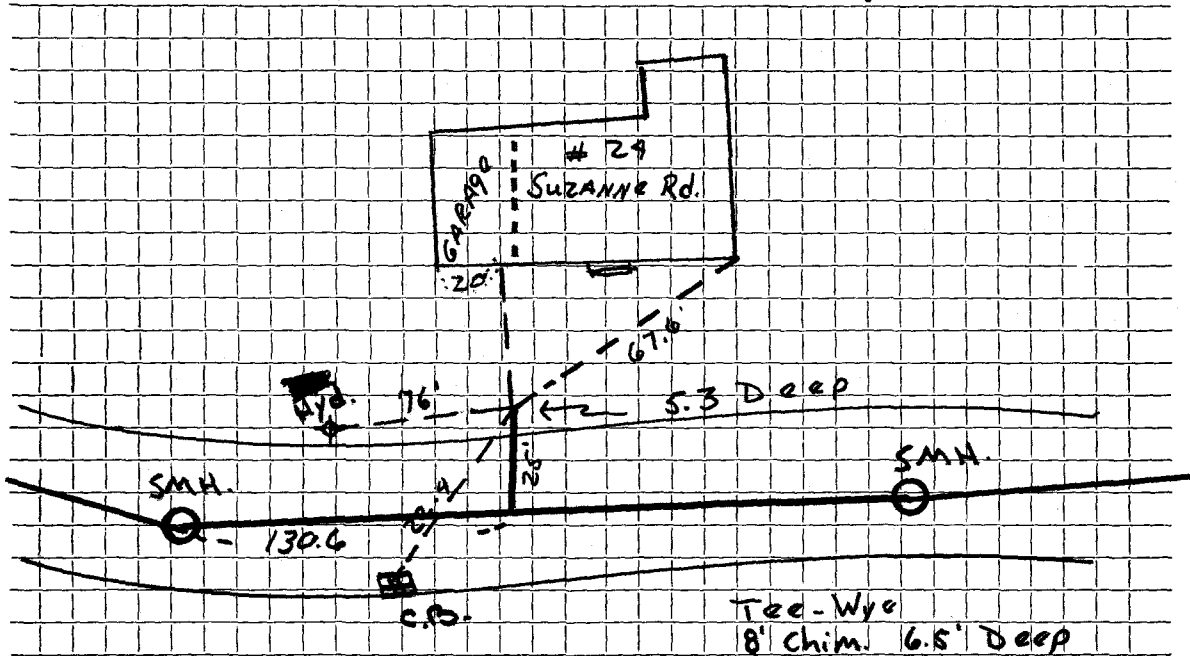

Connection made in Street. Work completed

Remarks:

.....
.....