

Name Herbert Pollack

Service No. 61 (79)

Address 25 Suzanne Road

25 Suzanne Road

Location

Kind of Pipe A.C.

Size 6"

Size of Main 8"

Repair—Renewal—New Service

Valeri #2565

Location AUG 16 1976


Date		Material	Amount		Total	Date		Amount	
11/14/	73	20' @ \$9.00	\$	180.00		9/23/74	Deposit	180.	00
10/2/74	111'	6" AC							
	5'	4" CAST Iron							

DATE \_\_\_\_\_

TOWN OF LEXINGTON — BOARD OF PUBLIC WORKS

SEWER DIVISION

Sketch of Service Here **25**

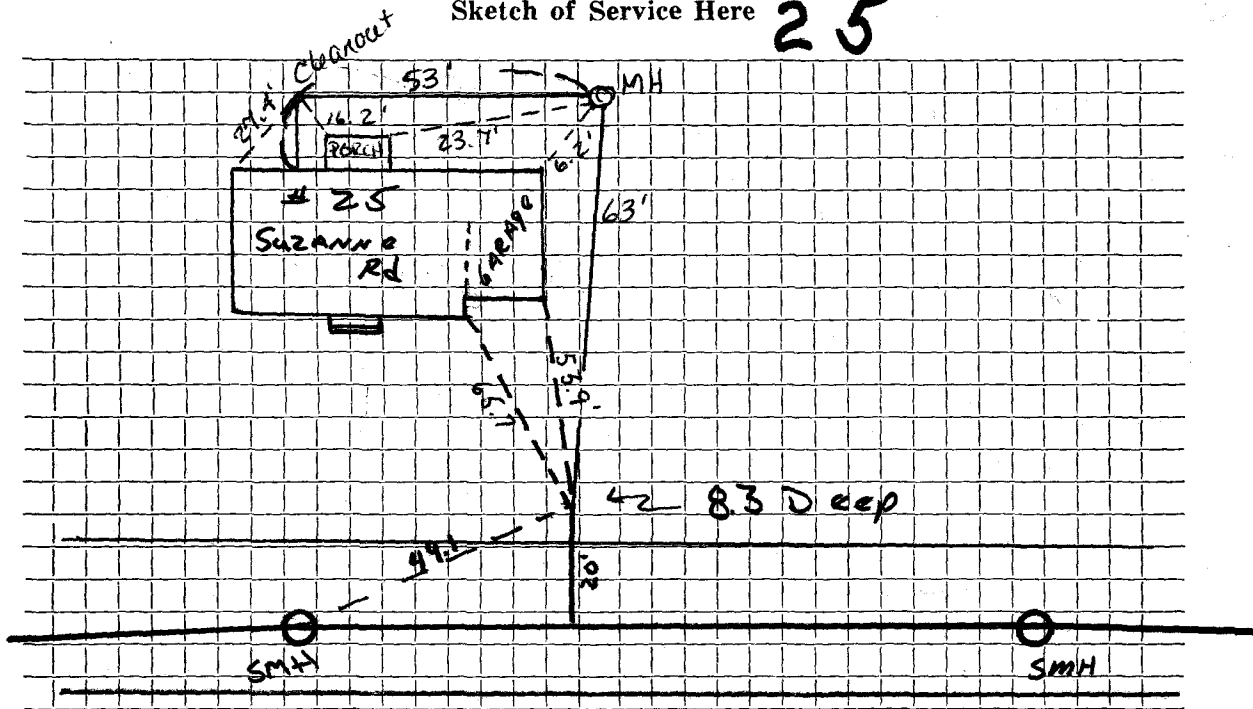

Connection made in ... SUZANNE ROAD ... Street.

Work completed ... 10-2-74 .....

Remarks: .....

.....

.....