
Date: <u>식/</u>교/&사

## TOWN OF LEXINGTON - BOARD OF PUBLIC WORKS SEWER DIVISION

## SKETCH OF SERVICE HERE

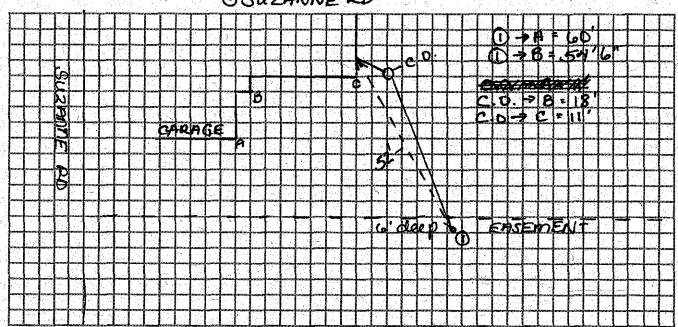

Connection made in:

Street.

Work completed:

Remarks: Installed by Speedwagon Partners

## Sewer Service Record

Name 3 Suzanne Rd	Service No.	
Address		
	Location	·
Kind of Pipe SDR 36 PVC	Size 💪 🕻	Size of Main 8" - Easement
Repair - Renewal - New Service		Location

Date	Material	Amount	Total	Date		Amount
4/2/24	6"3DR 35 PVC					
<b>,</b> , , , , , , , , , , , , , , , , , ,						
	6" Cleanout					
				/		
			-			
			<u></u>			
					<u>-</u> -	
						<u> </u>