

Name Chester Lanantea

Service No. 146

Address 4 SUZANNE RD.

4 SUZANNE Road

Location

Kind of Pipe

Size 6" A.C

Size of Main 8"

Repair—Renewal—New Service J. M. Lucente # 2413


Location APR 8 1974

Date	Material	Amount	Total	Date	Amount	
7/9/73	20' 6" A.C @ \$9.00	\$180.00		11-19-73	Deposit	180.00
11-16-73	60' - 6" ACP					
	38.6' - 4 CI					

DATE \_\_\_\_\_

TOWN OF LEXINGTON — BOARD OF PUBLIC WORKS  
SEWER DIVISION

Sketch of Service Here **4**

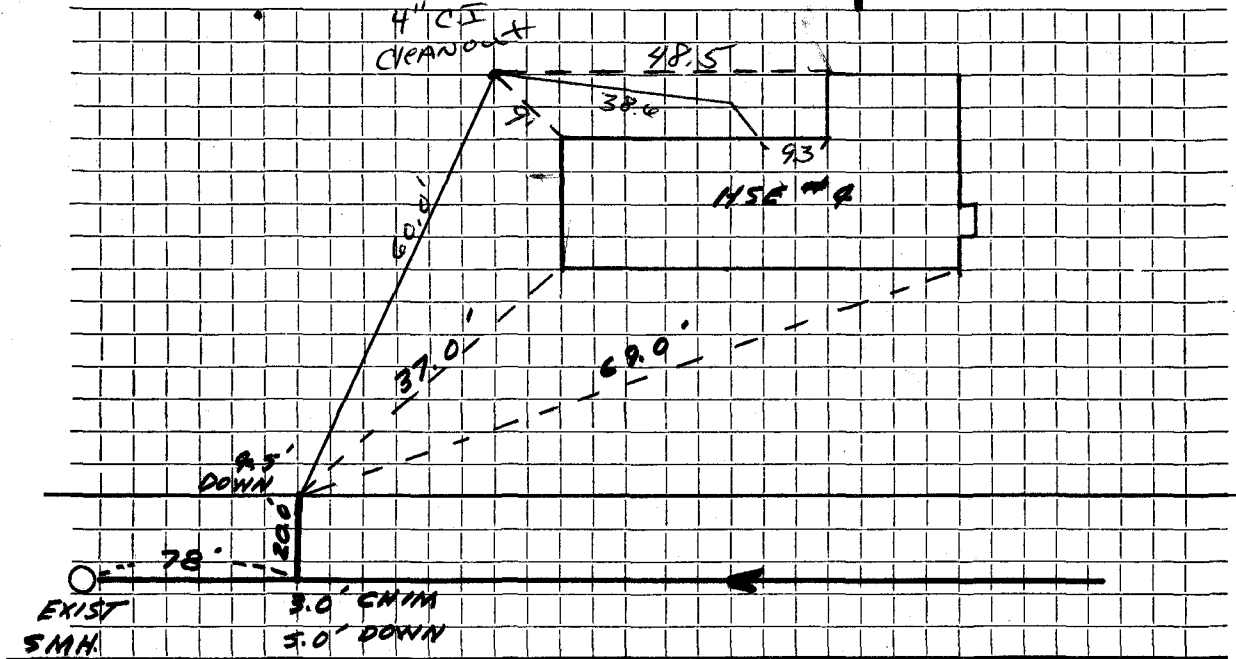

Connection made in ..... Street. Work completed .....

Remarks: .....  
.....  
.....