






DATE \_\_\_\_\_

**TOWN OF LEXINGTON — BOARD OF PUBLIC WORKS**  
**SEWER DIVISION**

Sketch of Service Here

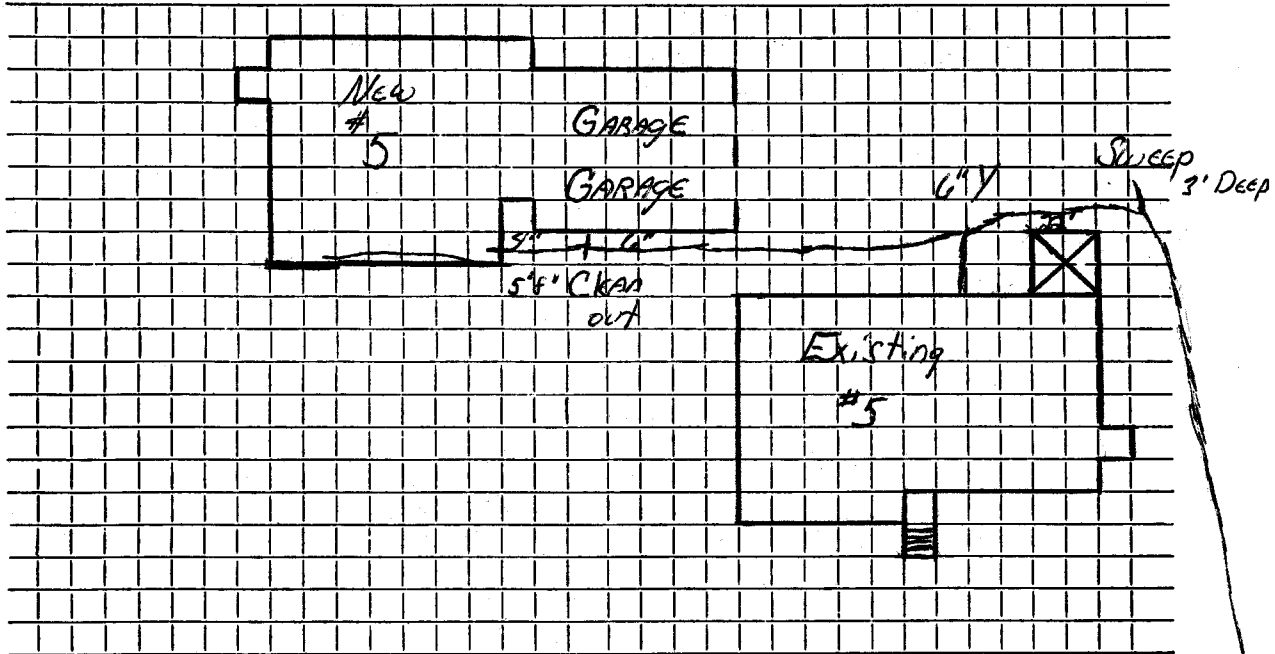

Connection made in ..... Street. Work completed .....

Remarks: .....

.....

.....

TOWN OF LEXINGTON — BOARD OF PUBLIC WORKS

SEWER DIVISION

LOCATION

NO.

DATE


LOCATION

Sketch of Service Here

5

LOCATION

NO.

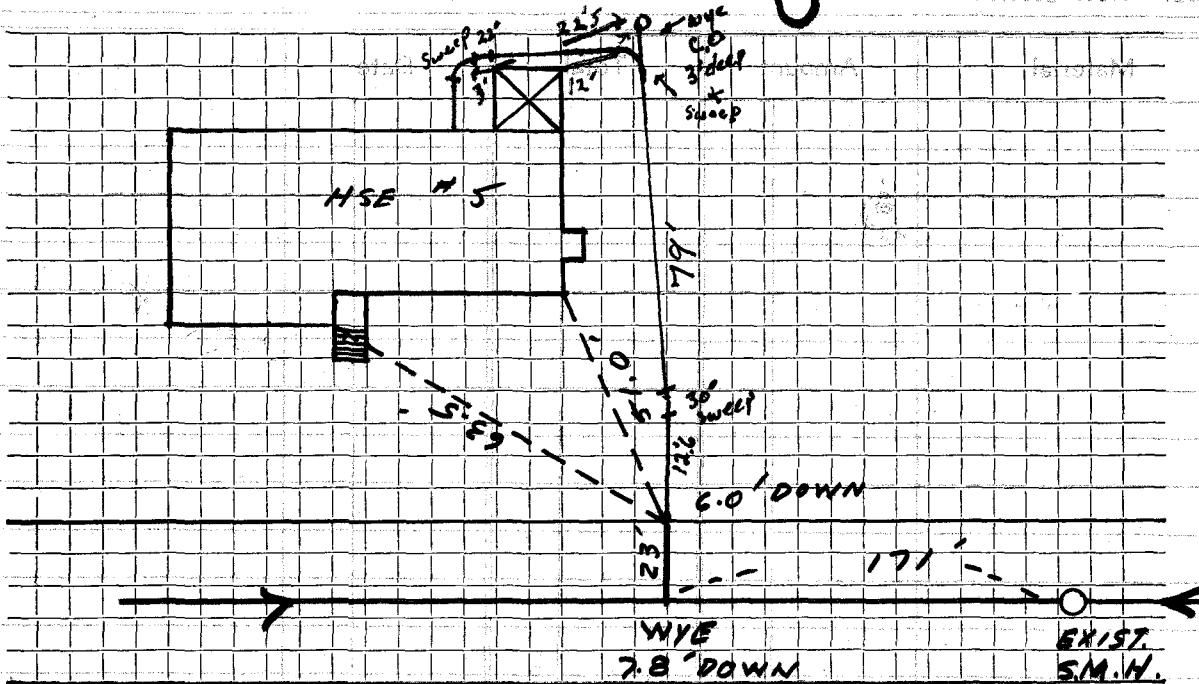

Connection made in ..... Street. Work completed .....

Remarks: .....

.....

.....