

Name Dr. Gino Passamonti

Service No. 122

Address 7 SUZANNE RD.

7 Suzanne Road

Location

Kind of Pipe A.C.

Size 6"

Size of Main 8"

Repair—Renewal—New Service Valeri #3145

Location NOV 19 1973


| Date | Material | Amount | Total | Date | Amount |
|---------|--------------------------|----------|-------|---------|----------------|
| 7/24/73 | 25.0'-6" A.C.P. @ \$9.00 | \$225.00 | | 9-21-73 | Deposit 225.00 |
| 1/27/73 | 67' 6" Transite pipe | | | | |
| | 10' 4" Cast Iron pipe | | | | |
| | | | | | |
| | | | | | |
DATE

TOWN OF LEXINGTON — BOARD OF PUBLIC WORKS

SEWER DIVISION

Sketch of Service Here 7

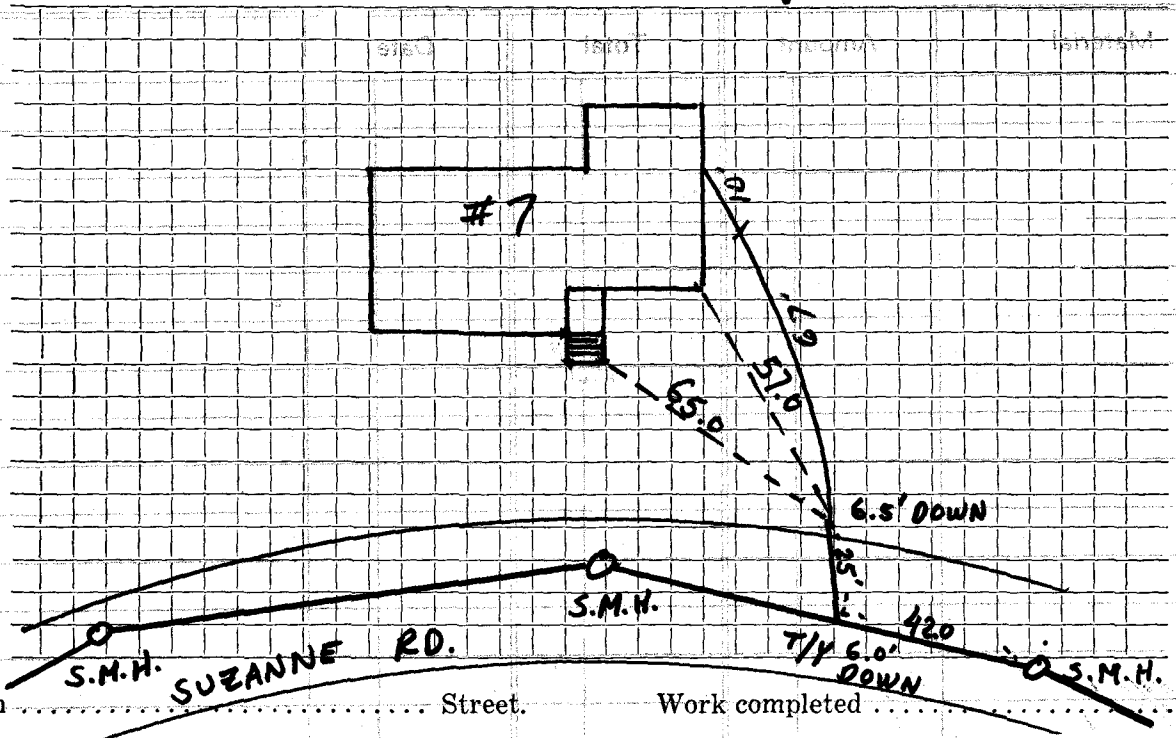

Connection made in Street. Work completed

Remarks: