

Name Donald Tucker

Service No. 36

Address #24 SWAN LANE

24 SWAN LANE

Location

Kind of Pipe AC & PVC

Size 6"

Size of Main 8" ACP

Repair ~~Renewal~~ New Service Faulkner #3896

Location NOV 19 1984


Date	Material	Amount	Total	Date	Amount
4/17/79	25'X6" ACP @	\$19.00	\$475.00	9-26-84	475.00
10/24/84	75' x 6" PVC				
	40' x 2" PVC				
	1 6" Wye				
	1 6" PVC x ACP Fernco				

Deposit

DATE APRIL 17, 1979

TOWN OF LEXINGTON — BOARD OF PUBLIC WORKS
SEWER DIVISION

Sketch of Service Here
EJECTOR PUMP 24

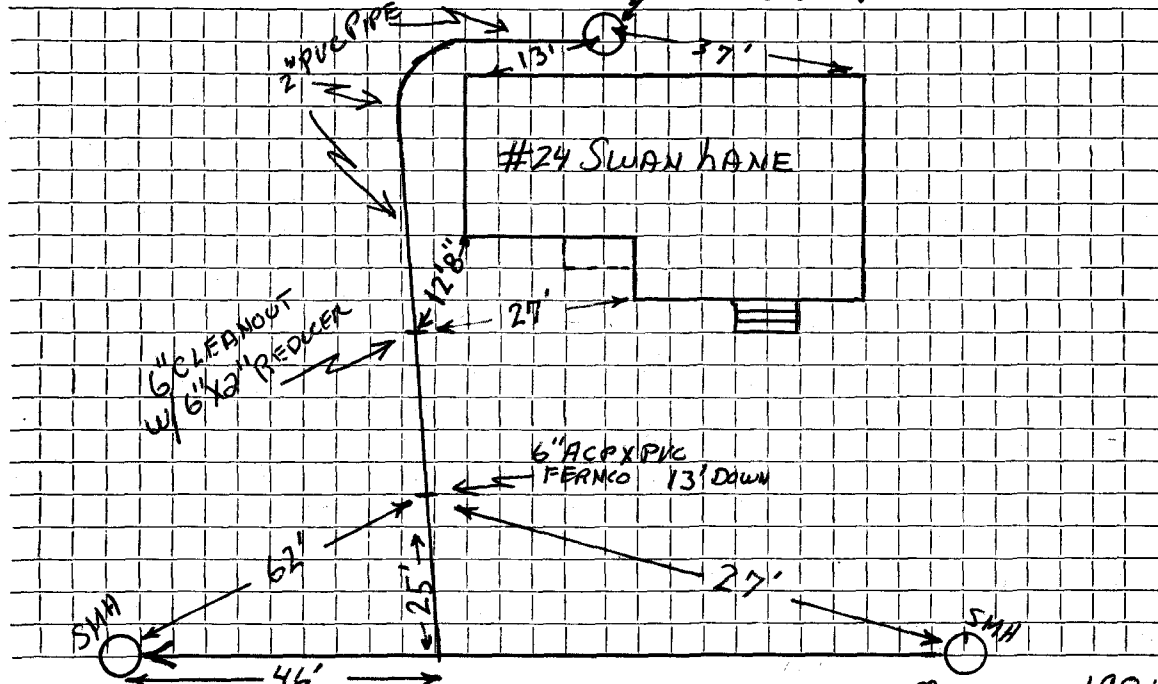

Connection made in SWAN LANE Street.

Work completed ... OCTOBER 1984

Remarks:

.....

.....