


DATE APRIL 1979

TOWN OF LEXINGTON — BOARD OF PUBLIC WORKS
SEWER DIVISION

Sketch of Service Here **25**

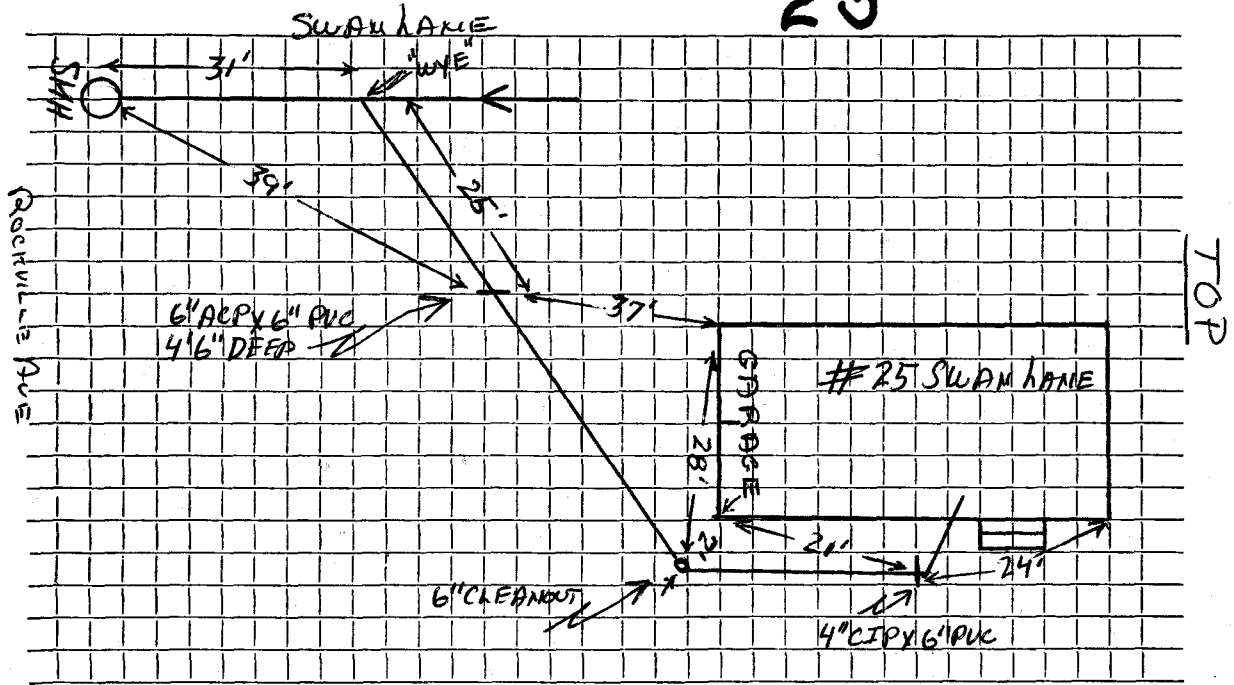

Connection made in SWAN LAKE..... Street. Work completed August 9, 1983.....

Remarks: