

Name Donald F. Green

Service No. 99

Address 13 Sylvania Street (vacant lot)

13 Sylvania Street

Location

Kind of Pipe

Size 6"

Size of Main 8"

~~REPAIR/RENEWAL~~ - New Service W.O. #2714 Valeri #1749

Location DEC 31 1970


Date	Material	Amount	Total	Date	Amount
7-7-66	Labor	33 09		10-2-70	75 19
	10% O.H.	<u>3 31</u>	36 40	Deposit	
24'	6" Transite pipe @ .88		21 12		
1	90° Elbow		4 09		
1	Adaptor		1 08		
2	Hrs. Trucking @ 3.00		6 00		
1	Hr. Shovel		<u>6 50</u>		
			75 19		
	(TO BE BILLED WHEN CONNECTED)				
10-21-70	27' 6" Transite pipe				
	10' 4" Cast Iron pipe				

DATE _____

TOWN OF LEXINGTON · — BOARD OF PUBLIC WORKS

SEWER DIVISION

Sketch of Service Here **13**

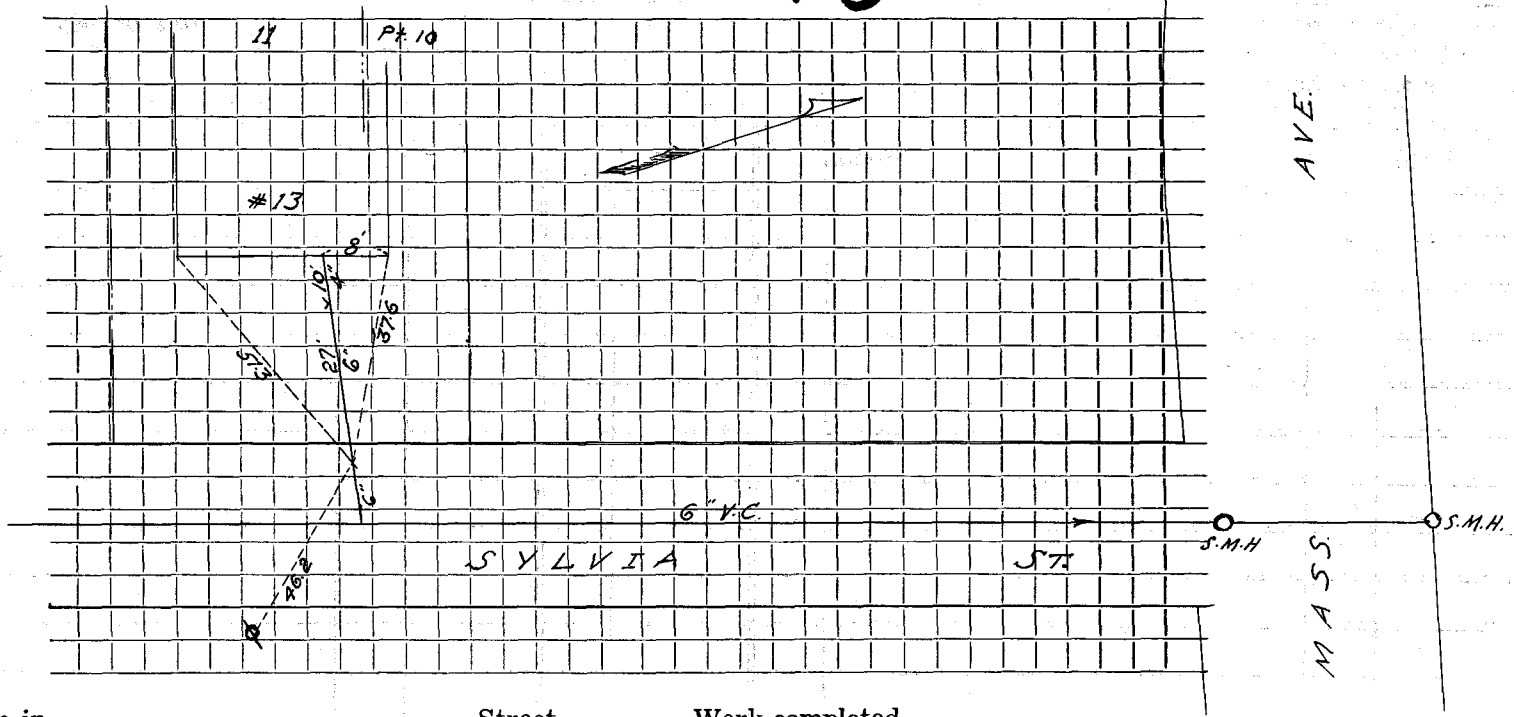

Connection made in Street. Work completed

Remarks:
.....
.....