

Name Benjamin Gott

Service No. 234

Address 29 Sylvia Street

29 Sylvia Street

Location Committed 4-2-56

Kind of Pipe

Size 6"

Size of Main 8"

Repair/Replacement - New Service

Location

Date	Material	Amount	Total	Date	Amount
1-4-56	Labor	16 50		12-28-55 Deposited	175 00
	10% overhead	1 65	18 15	4-2-56 Refunded	121 70
	40' - 6" Sewer pipe @ .50		20 00		53 30
	Joint Compound		2 40		
	1 hr. trucking		75		
	12x3 patching		12 00		
			53 30		
				3-5-62 Sewer Block	19 23
				2-29-64 S.B.	47 66
				12-28-65 BROKEN PIPE (?)	

TOWN OF LEXINGTON—DEPT. OF PUBLIC WORKS  
**SEWER DIVISION**

DATE.....

NO. ....


The undersigned applies for the construction of a particular sewer connecting No.....  
Street and hereby agrees to comply with the Rules and Regulations governing the construction and use of Particular  
Sewers, as now or at any future time established by the Board of Selectmen.

Am't of estimate \$.....

Am't Paid \$.....

..... Owner

Sketch of Service Here **29**

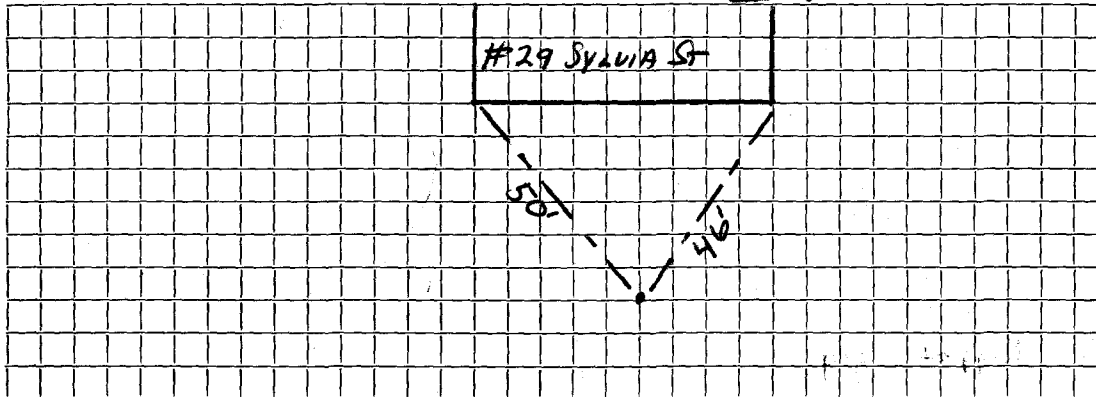

Connection made in..... Street.

Work completed.....19..

Remarks: