

C & C Construction Co.

Service No.

Address 35 Sylvia Street

35 Sylvia Street

Location

Kind of Pipe Valeri Const. Permit #235

Size 6"

Size of Main 8"

~~Repair~~ ~~Renewal~~ ~~New Service~~


Location

Date		Material	Amount	Total	Date	Amount
4-21-65	30'	5" Transite pipe to connect into Town of Arlington				

DATE \_\_\_\_\_

TOWN OF LEXINGTON — BOARD OF PUBLIC WORKS  
SEWER DIVISION

Sketch of Service Here **35**

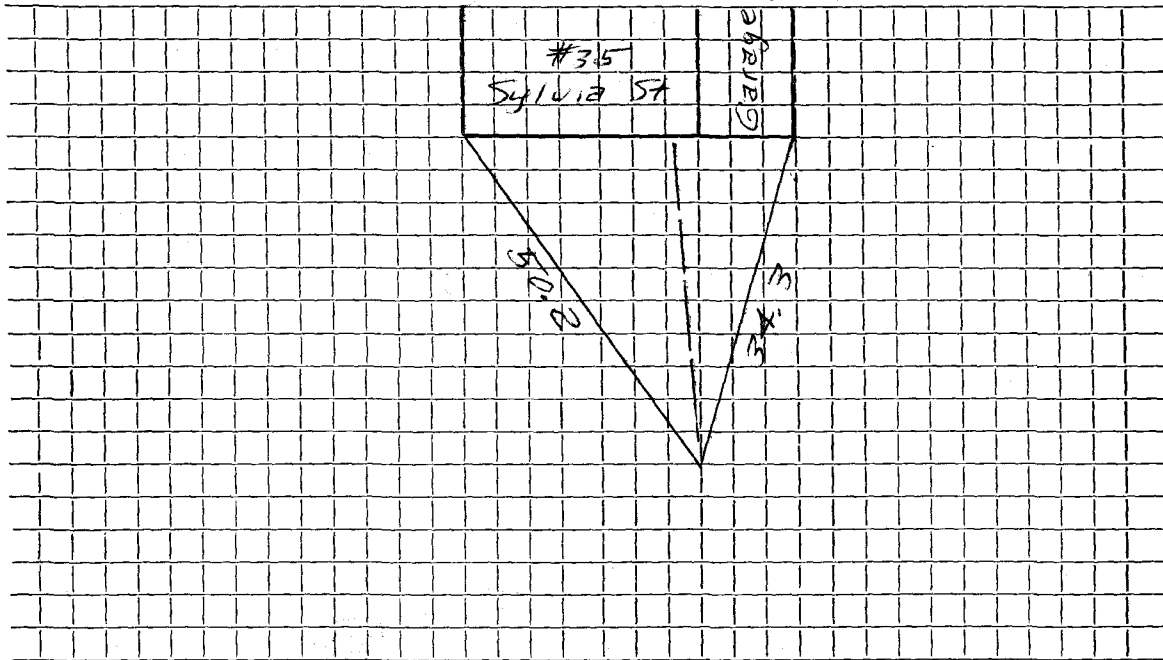

Connection made in ..... Street. Work completed .....

Remarks: .....  
.....  
.....