

Name C & C Construction Co.

Service No.

Address 39 Sylvania Street

Lot #1 39 Sylvania Street Location

Kind of Pipe Valeri Const. Co. Permit #236

Size 6"

Size of Main 8"

~~Repair~~ ~~Renewal~~ **New Service**


Location

Date	Material	Amount	Total	Date	Amount
4-15-65	56' 5" Transite pipe to connect into Town of Arlington				

DATE _____

TOWN OF LEXINGTON — BOARD OF PUBLIC WORKS
SEWER DIVISION

Sketch of Service Here **39**

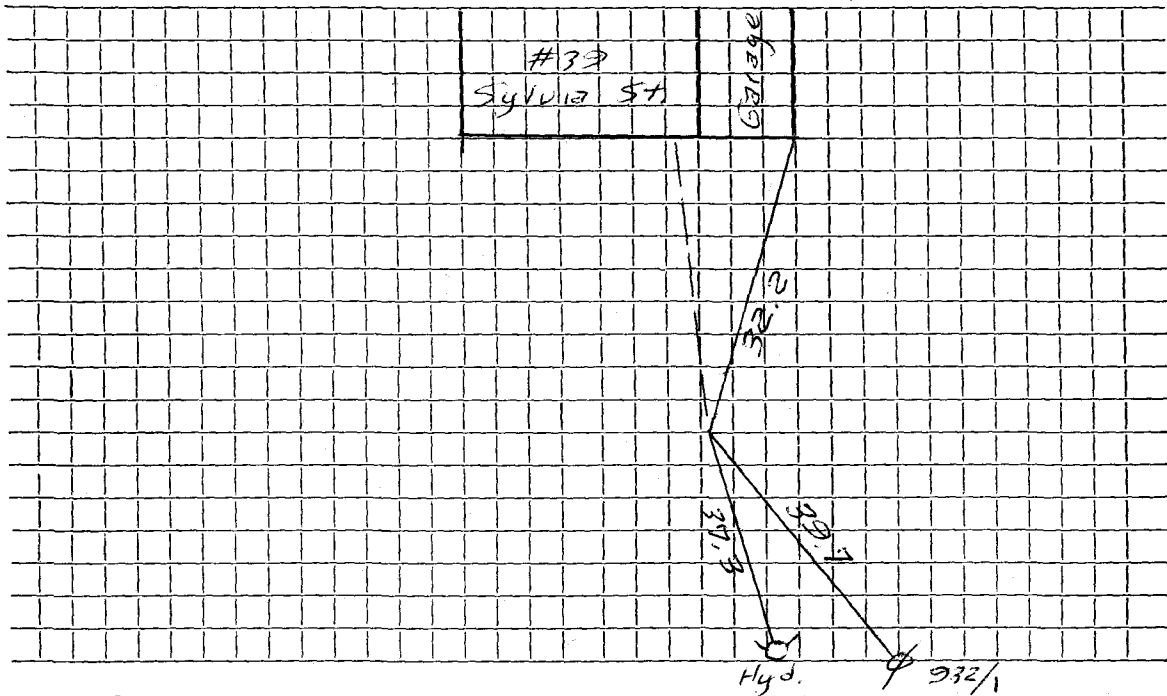

Connection made in Street. Work completed

Remarks:
.....
.....