

Name Mr. Frederick Lundergren

Service No. 19-937

Address 7+9 Sylvia St.

7+9 Sylvia Street

Location 7+9 Sylvia St

Kind of Pipe

Size 6"

Size of Main 8"

~~Renewal~~ New Service

Location

Date	Material	Amount	Total	Date	Amount
7-29-30 for 60.09	26' 6" Sewer Pipe @.30	7 80		May 29 1930 - Cash	60 09
	1 1/8" Bend	70			
	Sulphur & Jute	1 04			
	Trucking	<u>75</u>	10 29		
4/30	70 Hrs. Labor @.55	38 50			
	8 " " @.60	<u>4 80</u>	43 30		
	15% Overhead		<u>6 50</u>		
			60 09		
	Labor is for water & sewer				

TOWN OF LEXINGTON—BOARD OF PUBLIC WORKS

SEWER DIVISION

DATE May 24, 1930

NO. 7+9


The undersigned applies for the construction of a particular sewer connecting No. 77 Sylvia St. Street and hereby agrees to comply with the Rules and Regulations governing the construction and use of Particular Sewers, as now or at any future time established by the Board of Selectmen.

Am't. of Estimate \$ _____

Am't. Paid \$ _____

Frederick Lundergan Owner

Sketch of Service Here **7+9**

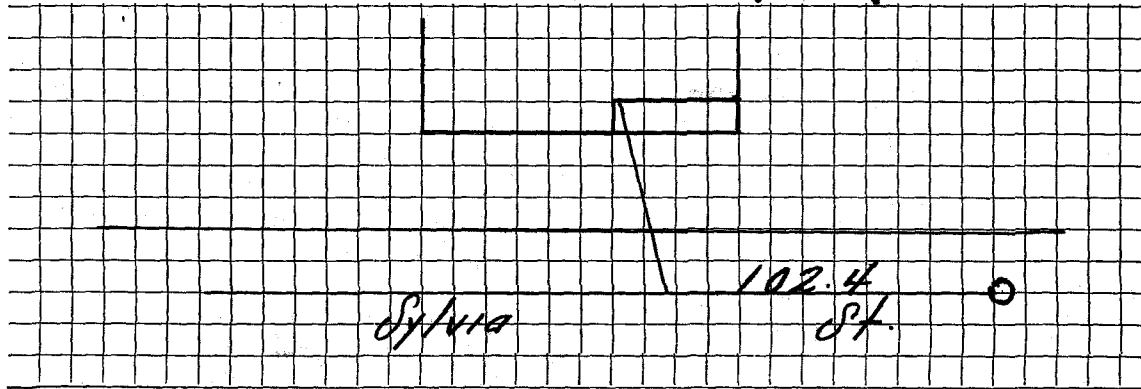

Connection made in _____ Street.

Work completed _____ 19

Remarks: