


DATE _____

TOWN OF LEXINGTON — BOARD OF PUBLIC WORKS
SEWER DIVISION

Sketch of Service Here **14**

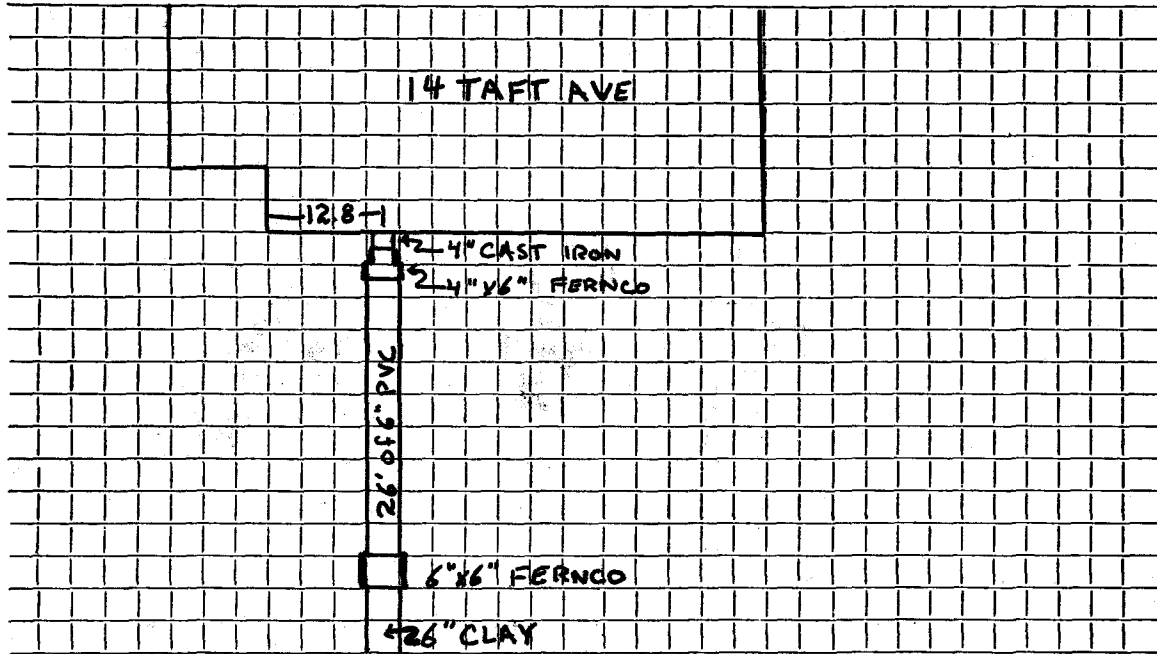

Connection made in TAFT AVE Street. Work completed

Remarks: WATER LINE IS 2.0' ABOVE SEWER. FERNCO IS 1.2' TOWARD STREET FROM WSO
Original Service 10-25-35 (40'-6" S. Pipe)