

Name Harry E. Johnson

Service No. 13 958

Address Massachusetts Avenue, Arlington

15 TAFT AVE

Location 15 Taft Avenue

Kind of Pipe

Size 6"

Size of Main 8"

~~Repair-Renewal~~ - New Service

Location

Date	Material	Amount	Total	Date	Amount
1935	22 hrs. @ 55¢	12 10		July 3, 1935 - Deposited	18 00
	2 " @ 60¢	1 20		Jan. 23, 1936	1 26
	10 7/8" Archd. on labor	1 33		Feb 18, 1936	3 38
23.51-10-22-35	43" 6" Sewer Pipe @ 16¢	6 88		June 25, 1936	87
	Sulphur & Jute	1 00			23 51
	Trucking	1 00			
			\$23 51	Billed 11-21-35	
	Labor				

Hadley Press, Inc., Lexington

45 W
18.00
CW

TOWN OF LEXINGTON—BOARD OF PUBLIC WORKS

SEWER DIVISION

DATE July 3, 1935.

NO. 13


The undersigned applies for the construction of a particular sewer connecting No. pt 36 Taft Avenue Street and hereby agrees to comply with the Rules and Regulations governing the construction and use of Particular Sewers, as now or at any future time established by the Board of Selectmen.

Am't. of Estimate \$ 18.00

Am't. Paid \$ _____

Harry L Johnson Owner

Sketch of Service Here

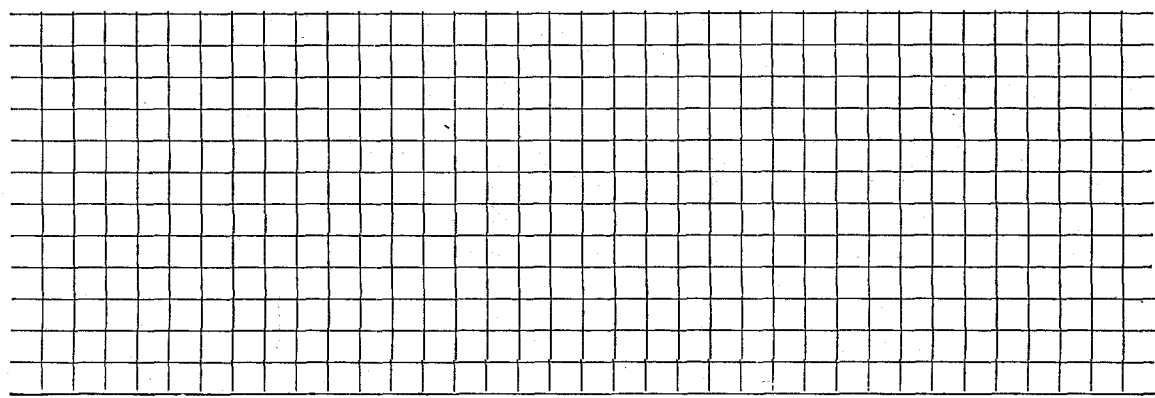

Connection made in _____ Street.

Work completed _____ 19

Remarks: