


DATE _____

TOWN OF LEXINGTON — BOARD OF PUBLIC WORKS
SEWER DIVISION

Sketch of Service Here

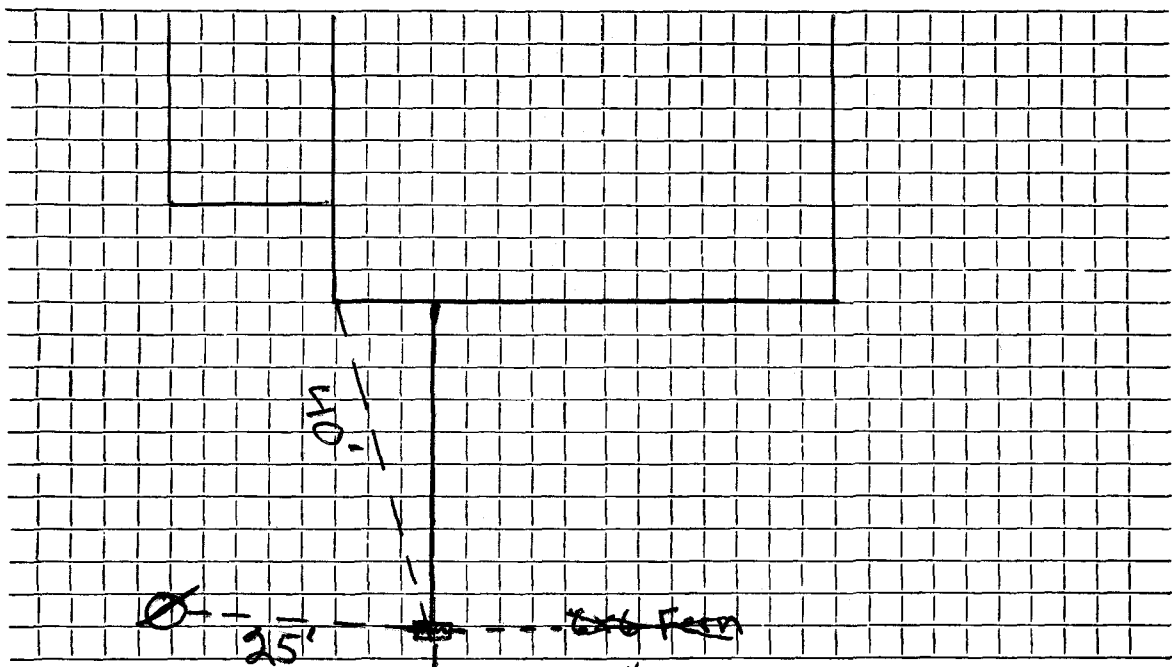

Connection made in Street. 12'-2" Work completed

Remarks:

..... 6" to clay Ferncoat

.....