

Name **Harry E. Johnson**

Service No. **22 901**

Address **50 Brighton Street, Belmont.**

19 Taft Ave

Location Lot **19 Taft Ave. #32 Taft Ave.,**

Kind of Pipe

Size **6"**

Size of Main **8"**

Repair—Renewal—New Service

rr' @ 6.75 35.75 Flat Rate

Location

Date	Material	Amount	Total	Date	Amount
June 21,	10 hrs. @ .60	6 00		<i>June 24 1937 Deposited</i>	35 75
<i>from 7/20/37</i>	15 hrs. @ .55	8 25			
	14 hrs. @ .50	7 00	21 25		
	10% Overhead		2 13		
	55' 6" Sewer Pipe @ .23		12 65		
	Joint Compound		2 80		
	2 hrs. Trucking @ .75		1 50		
			<u>40 33</u>		
	Flat rates 55' @ .65		<u>35 75</u>		
	Labor				

Hadley Press, Inc., Lexington

TOWN OF LEXINGTON—BOARD OF PUBLIC WORKS
SEWER DIVISION

DATE _____


NO. _____

The undersigned applies for the construction of a particular sewer connecting No. _____ Street and hereby agrees to comply with the Rules and Regulations governing the construction and use of Particular Sewers, as now or at any future time established by the Board of Selectmen.

Am't. of Estimate \$ _____

Am't. Paid \$ _____

_____ Owner

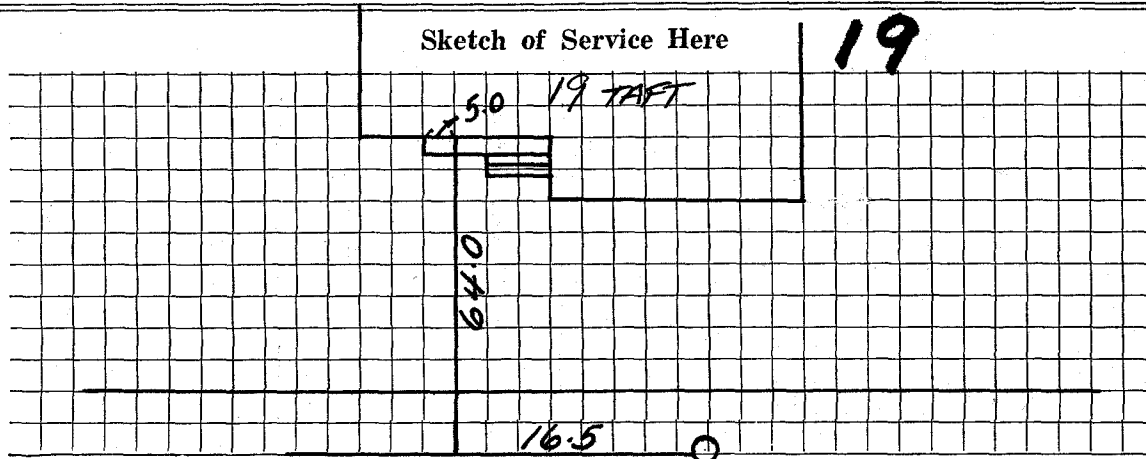

Connection made in _____ Street.

Work completed _____ 19

Remarks: