

Name **Harry E. Johnson**

Service No. **17 905**

Address **50 Brighton Street, Belmont.**

24 TAFT AVE

Location **Lot 28 - #24 Taft Ave.,**

Kind of Pipe

Size **6"**

Size of Main **8"**

Repair—Renewal—New Service

78' @ .60

46.80

Location

Date	Material	Amount	Total	Date	Amount
June 21,	16 hrs. @ .60	9 60		<i>June 4, 1937 Deposited</i>	46 80
<i>from 7/20/37</i>	25 hrs. @ .55	13 75			
	10 hrs. @ .50	5 00	28 35		
	Overhead		2 83		
	78' 6" Sewer pipe @ .23		17 94		
	Joint Compound		3 90		
	2 hrs. Trucking @ .75		1 50		
			<u>54 52</u>		
	Flat rate 78' @ .60		46 80		
	Labor				

Hadley Press, Inc., Lexington

TOWN OF LEXINGTON—BOARD OF PUBLIC WORKS

SEWER DIVISION

DATE Dec 17-36

24 Tapt NO. _____

The undersigned applies for the construction of a particular sewer connecting No. Lot 28 Tapt Ave Street and hereby agrees to comply with the Rules and Regulations governing the construction and use of Particular Sewers, as now or at any future time established by the Board of Selectmen.


Am't. of Estimate \$ _____

Am't. Paid \$ _____

Harry E. Johnson Owner
Wm. E. Sahlberg

Sketch of Service Here

24

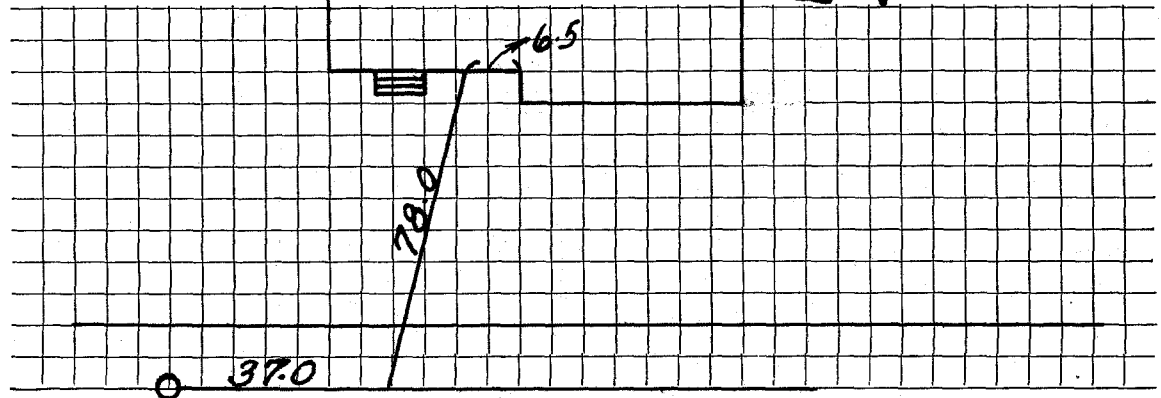

Connection made in _____ Street.

Work completed _____ 19

Remarks: