

Name **Harry E. Johnson**

Service No. **20 966**

Address ~~50 Brighton Street, Belmont.~~

25 Taft Ave

Location ^{25 Taft Ave} Lot #30 Taft Ave.,

Kind of Pipe

Size **6"**

Size of Main **8"**

Repair—Renewal—New Service

50' @ 65¢ 32.50 Flat Rate

Location

Date	Material	Amount	Total	Date	Amount
June 21,	10 hrs. @ .60	6 00		<i>June 24, 1937 Deposited</i>	32 50
<i>Sum 7/20/37</i>	15 hrs. @ .55	8 25			
	8 hrs. @ .50	<u>4 00</u>	18 25		
	Overhead		1 83		
	50' 6" Sewer pipe @ .23		11 50		
	Joint Compound		2 50		
	2 hrs. Trucking @ .75		<u>1 50</u>		
			35 58		
	Flat rates 50' @ .65		<u>32 50</u>		
	Labor				

Hidley Press, Inc., Lexington

TOWN OF LEXINGTON—BOARD OF PUBLIC WORKS

SEWER DIVISION

DATE Dec 17 - 96

NO. _____

The undersigned applies for the construction of a particular sewer connecting No. Lot 30 Taft Ave Street and hereby agrees to comply with the Rules and Regulations governing the construction and use of Particular Sewers, as now or at any future time established by the Board of Selectmen.

Am't. of Estimate \$ _____


Am't. Paid \$ _____

Harry O Johnson Owner
By E. W. Sabbe

25 TAFT

Sketch of Service Here

25

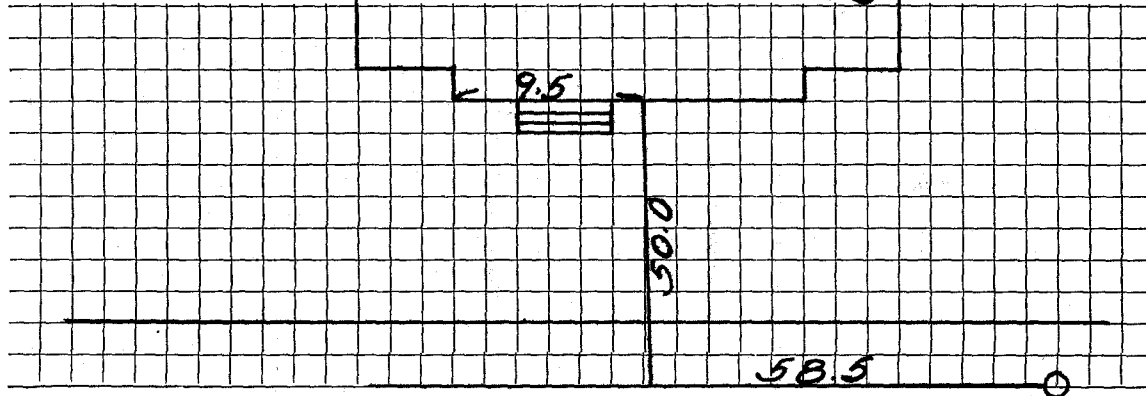

Connection made in _____ Street.

Work completed _____ 19

Remarks: