

Name **Harry E. Johnson**Service No. **18****967**Address **50 Brighton Street, Belmont****26 Taft Ave**Location **Lot 29- 26 Taft Ave.,**

Kind of Pipe

Size **6"**Size of Main **8"**

Repair—Renewal—New Service

58' @ .60 34.80

Location

Date

Material

Amount

Total

Date

Amount

June 21

15 hrs. @ .60

9 00

*June 7, 1937 Deposited***34 80***DN 7/20/37*

20 hrs. @ .55

11 00

9 hrs. @ .50

4 50

24 50

Overhead

2 45

58' 6" Sewer Pipe

@ .23

13 34

Joint Compound

2 90

2 hrs. Trucking

@ .75

1 50

44 69

Flat rate 58' @.60

34 80

Labor

TOWN OF LEXINGTON—BOARD OF PUBLIC WORKS

SEWER DIVISION

DATE Dec 17 - 36

26 Taft.


NO. _____

The undersigned applies for the construction of a particular sewer connecting No. Lot 29 Taft Ave Street and hereby agrees to comply with the Rules and Regulations governing the construction and use of Particular Sewers, as now or at any future time established by the Board of Selectmen.

Am't. of Estimate \$ _____

Am't. Paid \$ _____

Harry E. Johnson Owner
By Fred W. Selby

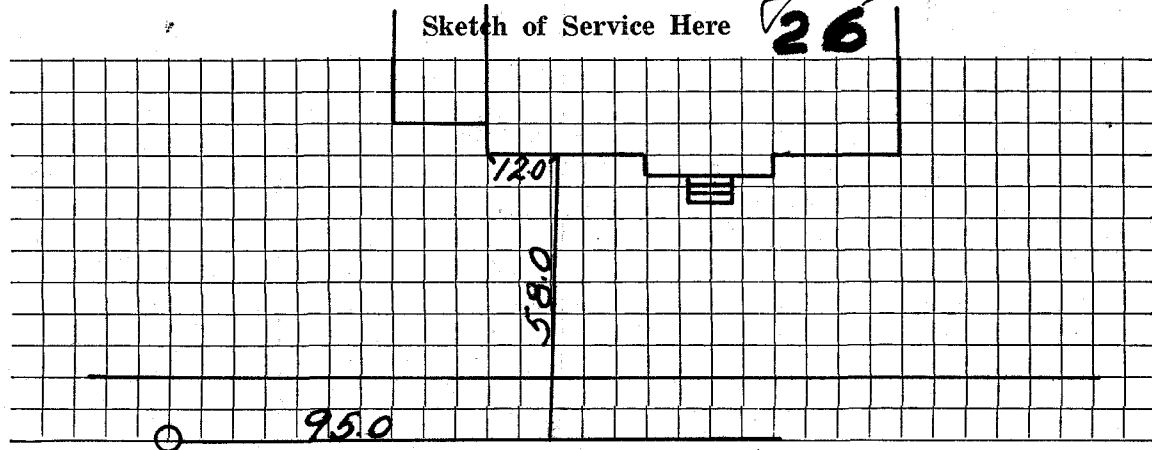

Connection made in _____ Street.

Work completed _____ 19

Remarks: