

Name Lexington Homes, Inc.

Service No. 22

968

Address Lexington, Mass.

27 Taft Ave

Location 27 Taft Avenue

Kind of Pipe

Size 6"

Size of Main 8"

Repair—Renewal—New Service

Location

Date 1941	Material	Amount	Total	Date	Amount
Nov. 8,	60 hrs. @ 50¢	30 00		October 20, 1941	60 00
Com 12/22/41	24 " @ 60¢	14 40	44 40	12/31/41	4 37
	10% Overhead		4 44	February 10, 1942	2 25
	74' 6" Sewer pipe @ 16¢		11 84		
	Joint Compound		4 44		
	2 hrs. trucking @ 75¢		1 50		
			66 62		
				Beef for r.v. sent 12/31/41	
				Credit refund 43.00	
				Water meter # 122	
	Labor				

TOWN OF LEXINGTON—BOARD OF PUBLIC WORKS

SEWER DIVISION

DATE Oct 17, 1941


NO. _____
27 Taft Ave Lot # 20

The undersigned applies for the construction of a particular sewer connecting No. 27 Street and hereby agrees to comply with the Rules and Regulations governing the construction and use of Particular Sewers, as now or at any future time established by the Board of Selectmen.

Am't. of Estimate \$ 60-

Am't. Paid \$ _____

Lexington Homes, Inc. Owner

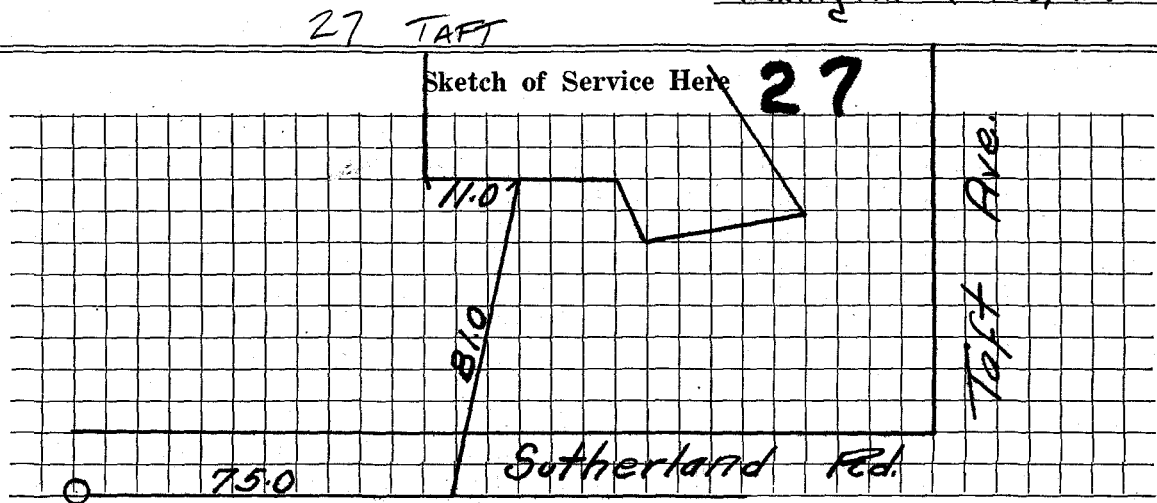

Connection made in _____ Street. Work completed _____ 19

Remarks: