

Name Lexington Homes, Inc.

Service No. 10

969

Address ~~Lexington, Mass.~~

28 TAFT AVE

Location

28 Taft Avenue

Kind of Pipe

Size 6"

Size of Main 8"

Repair—Renewal—New Service

Location

Date 1941	Material	Amount	Total	Date	Amount
Sept. 10	32 hrs. @ 60¢	19 20		Nov. 19, 1941 Paid	40 71
Com 10/13/41	13 " @ 65¢	8 45	✓ 27 65		
	10% Overhead		✓ 2 76		
	40' 6" Sewer Pipe @ 16¢		✓ 6 40		
	Jointing compound		✓ 2 40		
	Trucking, 2 hrs. @ 75¢		✓ 1 50		
			40 71	Oct 22, 1941 Billsent	
	Labor				

Hadley Press, Inc., Lexington

TOWN OF LEXINGTON—BOARD OF PUBLIC WORKS
SEWER DIVISION

DATE August 21, 1941


NO. _____

The undersigned applies for the construction of a particular sewer connecting No. 28 Taft Avenue (26) Street and hereby agrees to comply with the Rules and Regulations governing the construction and use of Particular Sewers, as now or at any future time established by the Board of Selectmen.

Am't. of Estimate \$ 75-

Am't. Paid \$ _____

*Lexington Home Club, owner by
W. P. Phillips, Jr. - Pres.*

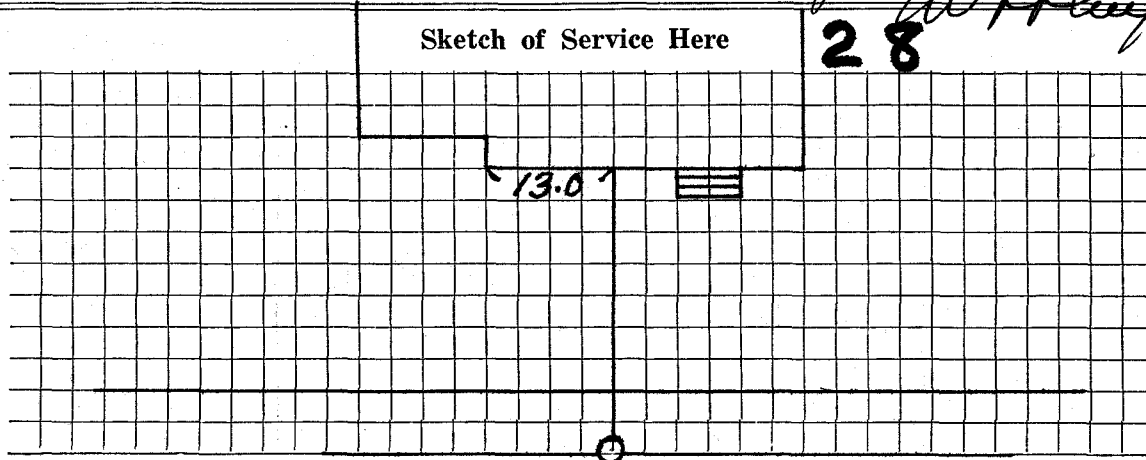

Connection made in _____ Street.

Work completed _____ 19

Remarks: