

Name Waverley Construction Co.

Service No. 15 1029

Address 30 Taft Avenue

Lexington, Mass.

Location 30 Taft Avenue

Kind of Pipe

Size 6"

Size of Main 8"

~~Repair~~ ~~Renewal~~ New Service *Com 12-9-16*

Location

Date	Material	Amount	Total	Date	Amount
Aug. 23, '46	Labor	28 30		Aug. 6 '46	70 00
24, '46	"	7 77	46 07	Dec. 16 '46	9 55
	10% Overhead		4 61		73 55
	38' 0 6" Sewer Pipe @.255		9 69		
	2 - 6" Elbows		1 40	Bill sent 12-10-46	
	Joint Compound		2 28		
	Compressor 5 hrs. @1.75		8 75		
	Trucking 1 hr. @.75		75		
			73 55		
	Labor				

TOWN OF LEXINGTON—DEPT. OF PUBLIC WORKS
SEWER DIVISION

DATE


NO.

The undersigned applies for the construction of a particular sewer connecting No.
Street and hereby agrees to comply with the Rules and Regulations governing the construction and use of Particular
Sewers, as now or at any future time established by the Board of Selectmen.

Am't of estimate \$.....

Am't Paid \$.....

..... Owner

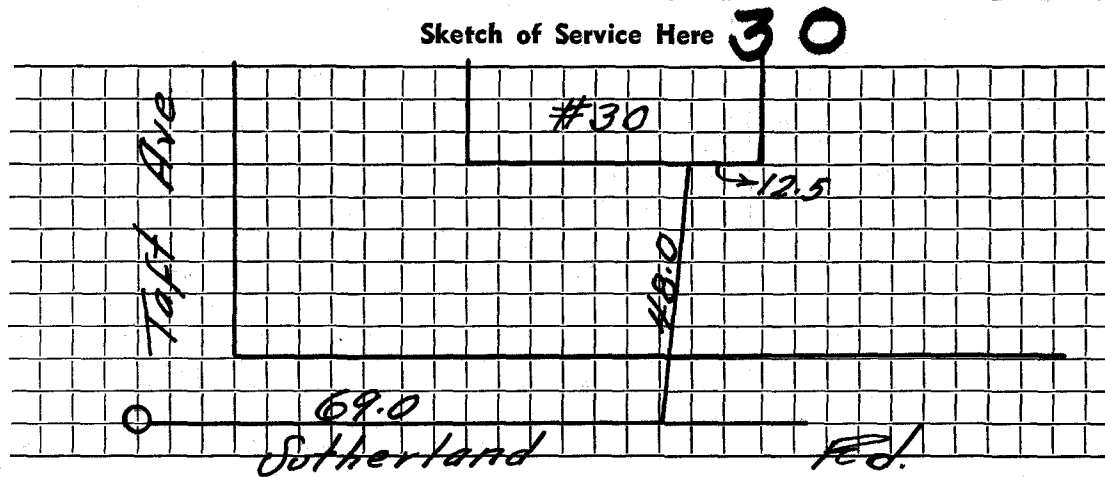

Connection made in Street.

Work completed 19..

Remarks: