

Name Donald K. Irwin

Service No. 1076

Address 33 Taft Avenue

Lexington, Mass.

Location 33 Taft Avenue

Kind of Pipe

Size 6"

Size of Main 8"

~~Repair/Renewal~~ — New Service

Location

Date		Material	Amount	Total	Date		Amount
June 2,	1947	Labor	23 80		May 23	1947	45 00
3		"	56 70	80 50	May 13	1948	66 55
		10% Overhead		8 05			111 55
		63' - 6" Sewer Pipe @.26		16 38			
		1 - 6" Y		1 28			
		Joint Compound		3 84			
		Trucking 2 hrs. @.75		1 50			
				<u>111 55</u>		Bill sent 1-6-48	
		Labor					

TOWN OF LEXINGTON—DEPT. OF PUBLIC WORKS
SEWER DIVISION

DATE

NO.


The undersigned applies for the construction of a particular sewer connecting No. Street and hereby agrees to comply with the Rules and Regulations governing the construction and use of Particular Sewers, as now or at any future time established by the Board of Selectmen.

Am't of estimate \$..... *58 Taft corner*

Am't Paid \$.....

..... Owner

Sketch of Service Here **33**

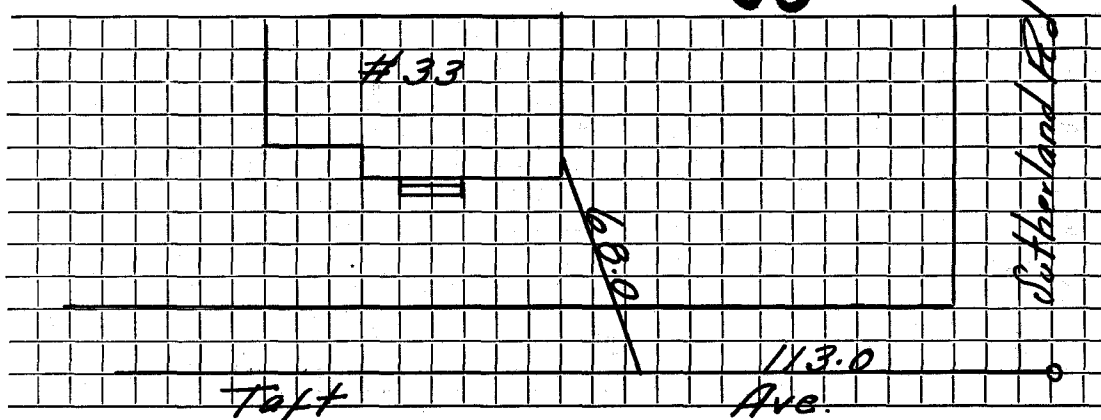

Connection made in Street.

Work completed 19..

Remarks: