


DATE _____

TOWN OF LEXINGTON — BOARD OF PUBLIC WORKS

SEWER DIVISION

Sketch of Service Here

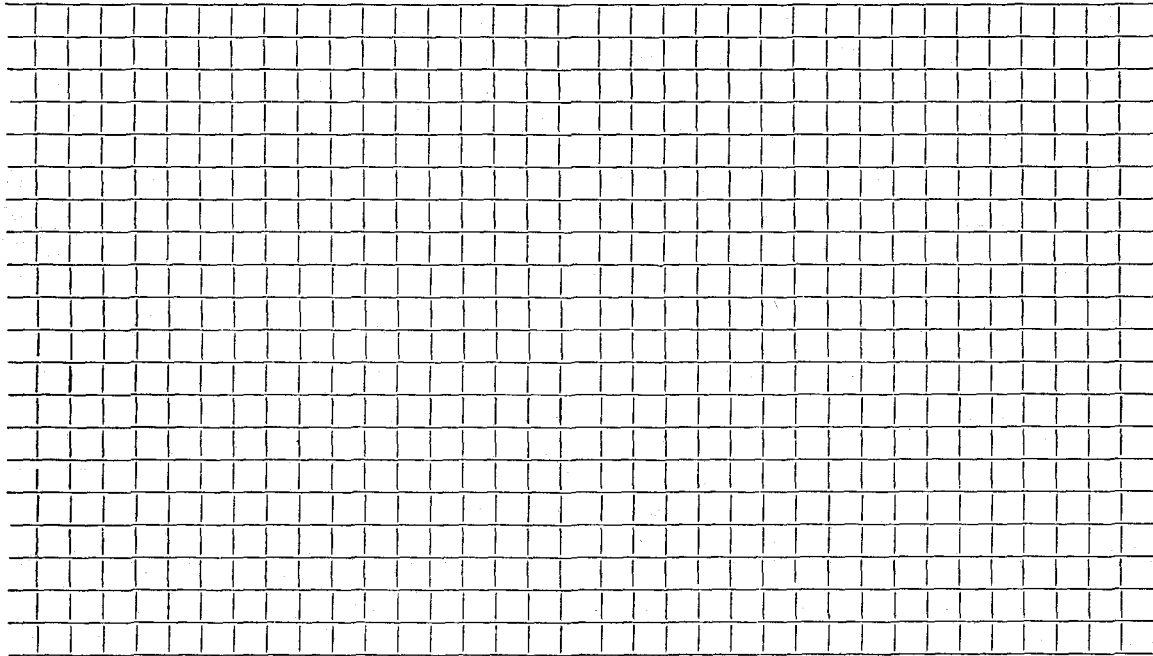

Connection made in Street. Work completed

Remarks: *Original Service 11-7-34 (36'-6" Sewer Pipe, 10' 4" C.I. Pipe)*.....

.....
.....