


DATE 1/6/94

TOWN OF LEXINGTON — BOARD OF PUBLIC WORKS
SEWER DIVISION

Sketch of Service Here

4

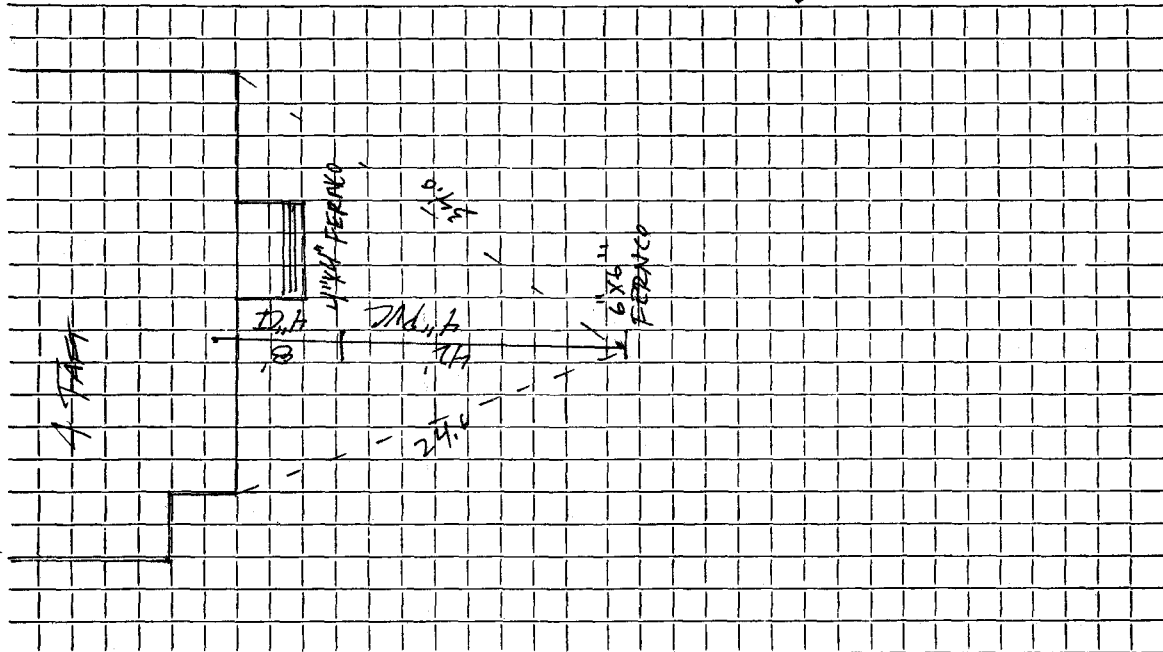

Connection made in Street. Work completed 9/6/93 BRUCE MCKEE.....
Remarks: Original Service 9-30-39 (34'-6" Sewer Pipe)