

Name Busa Realty

Service No. 130

Address 51 Taft Avenue

51 Taft Ave.

Location

Kind of Pipe

Size 6"

Size of Main 8"

~~Repair - Renewal - New Service~~

W.O. # 8359 *De File # 1990*

Location APR 26 1972

Date	Material	Amount	Total	Date	Amount
12/27/72	Labor	111 34		12-17-71	<i>Deposit</i> 175 00
	10% O.H.	11 13	122 47	5-5-72	<i>Balance Paid</i> 34 37
20'	6" Transite pipe .90		18 00		<u>209.37</u>
3	X 6" Nipple		4 00		
	6" Cap		2 55	12/27/71	NO CHARGE
1	Ton Cold Patch		8 00		Labor 43 52
3	Ton Hot Top 7.45		22 35		
2	Hrs. Trucking 3.00		6 00		
4	Hrs. Shovel 6.50		26 00		
			<u>209 37</u>		
1-5-72	23' 6" Transite pipe				
	10' 4" Cast Iron pipe				
					<i>Balance 34.37</i>


DATE _____

TOWN OF LEXINGTON — BOARD OF PUBLIC WORKS

SEWER DIVISION

Sketch of Service Here

51

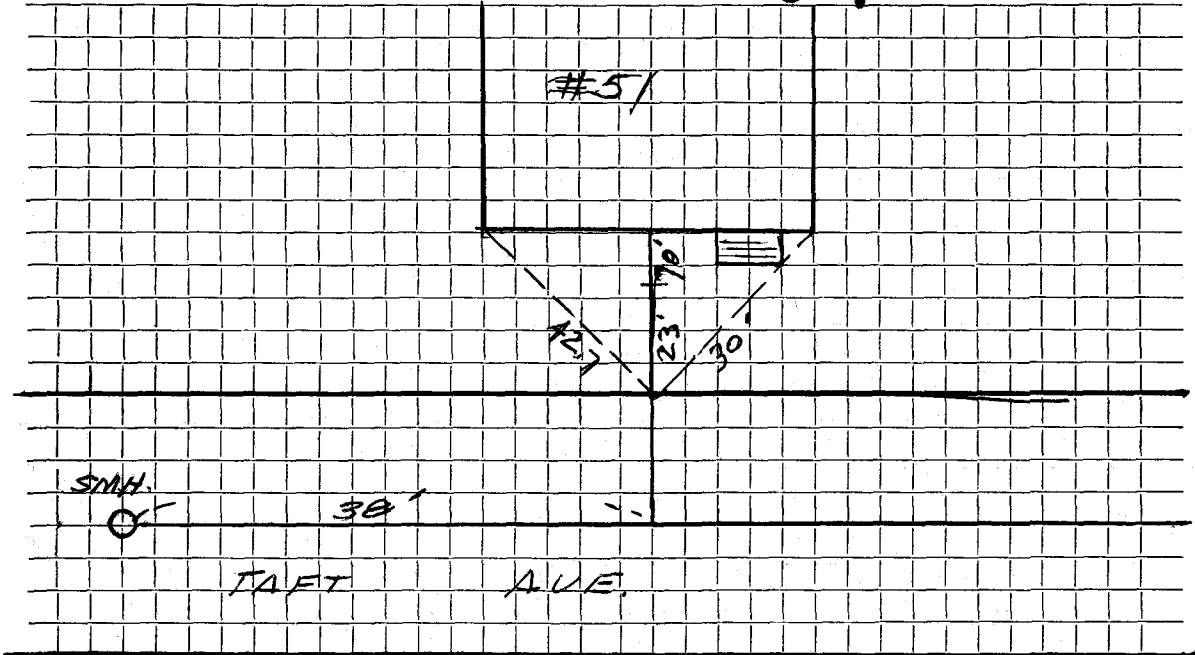

Connection made in Street. Work completed

Remarks:
.....
.....