

Name Contractor: Santo

Service No.

Address 54 Taft Avenue

Location

Kind of Pipe SDR 35 PVC

Size 6"

Size of Main

~~Repair~~—Renewal—New Service


Location

Date	Material	Amount	Total	Total	Date		Amount
8/23/2020	6" SDR 35 PVC						
	6" cleanout						
	6" 45° bend						

DATE 8/23/2020

TOWN OF LEXINGTON — BOARD OF PUBLIC WORKS
SEWER DIVISION

Sketch of Service Here

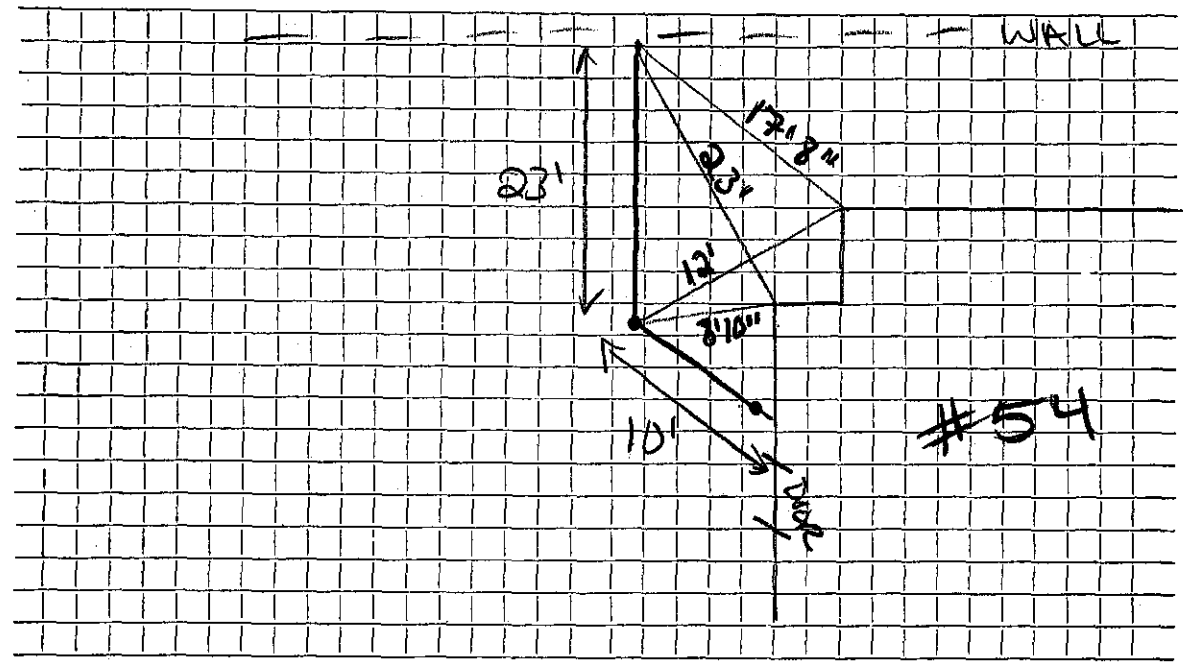

Connection made in Taft Ave Street. Work completed

Remarks: Door to Cleanout = 3'
.....
.....