

Name Donald K. L...Service No. 109CAddress 55 Taft Avenue

Lexington, Mass.

Location 55 Taft Avenue

Kind of Pipe

Size 6"Size of Main 8"

Repair—Renewal—New Service

Location

Date	Material	Amount	Total	Date	Amount
Oct. 16, '47	Labor	27 15		Oct 14 47	85 00
17	"	3 75	30 90	Nov 29 47	6 82
	10% Overhead		3 09		79 18
	42' - 6" Sewer Pipe @.26		10 92		
	Joint Compound .		2 52		
	Hired Shovel 3 hrs. @7.00		21 00		
	Trucking 1 hr. @.75		75		
	Patching 10 x 3		10 00		
			79 18		
	Labor			1-10-62	24 46
	Com 11-24-47				

TOWN OF LEXINGTON—DEPT. OF PUBLIC WORKS
SEWER DIVISION

DATE

NO.


The undersigned applies for the construction of a particular sewer connecting No.
Street and hereby agrees to comply with the Rules and Regulations governing the construction and use of Particular
Sewers, as now or at any future time established by the Board of Selectmen.

Am't of estimate \$.....

Am't Paid \$.....

..... Owner

Sketch of Service Here **55**

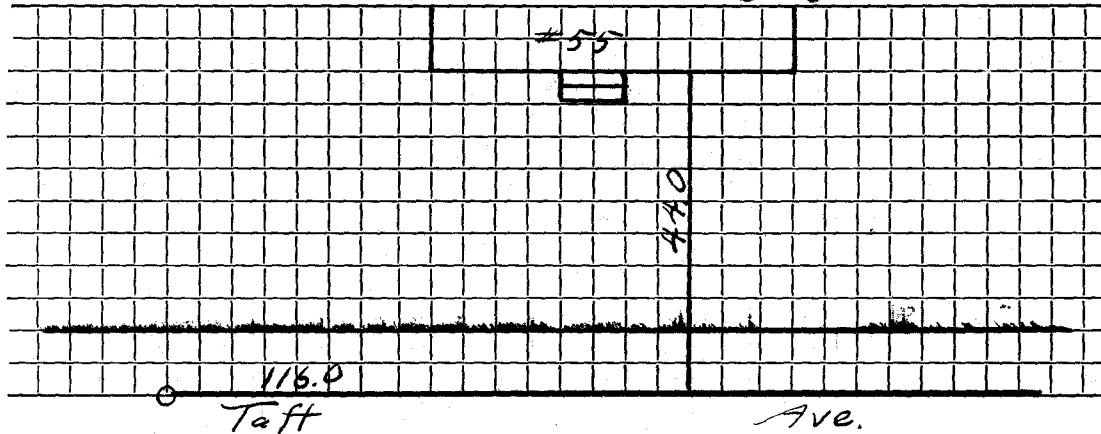

Connection made in Street.

Work completed 19..

Remarks: