

Name Donna Realty Trust

Service No. 128

Address 56 A Taft Avenue

56 A Taft Ave.

Location

Kind of Pipe

Size 6"

Size of Main 8"

~~Repair~~ ~~Renewal~~ - New Service W.O. #5601 Valeri #837

Location AUG 5 1968


Date	Material	Amount	Total	Date	Amount
10-16-67 25'	6" Transite pipe			10-4-67	150 00
10'	4" Cast Iron pipe			8-5-68 A	14 66
10/12/67	Labor	34 92			135 34
	Labor	17 60			
	Labor	6 02			
	10% O.H.	5 84	64 38		
18'	6" transite pipe @ .88		15 84		
1/8	bag cement @ 1.55		39		
1	6" cap		1 63		
1	ton hold patch		5 50		
2	ton hot top		11 60		
3 1/2	hrs. trucking @ 3.00		9 75		
2 1/2	hrs. shovel @ 6.50		16 25		
1/2	hr. compressor		2 50		
1	hr. loader		4 00		
1/2	hr. roller & trailer		3 50		
		TOTAL COST	135 34		

Applied to SHC#101
Applied to SHC#125

DATE _____

TOWN OF LEXINGTON — BOARD OF PUBLIC WORKS
SEWER DIVISION

Sketch of Service Here **56A**

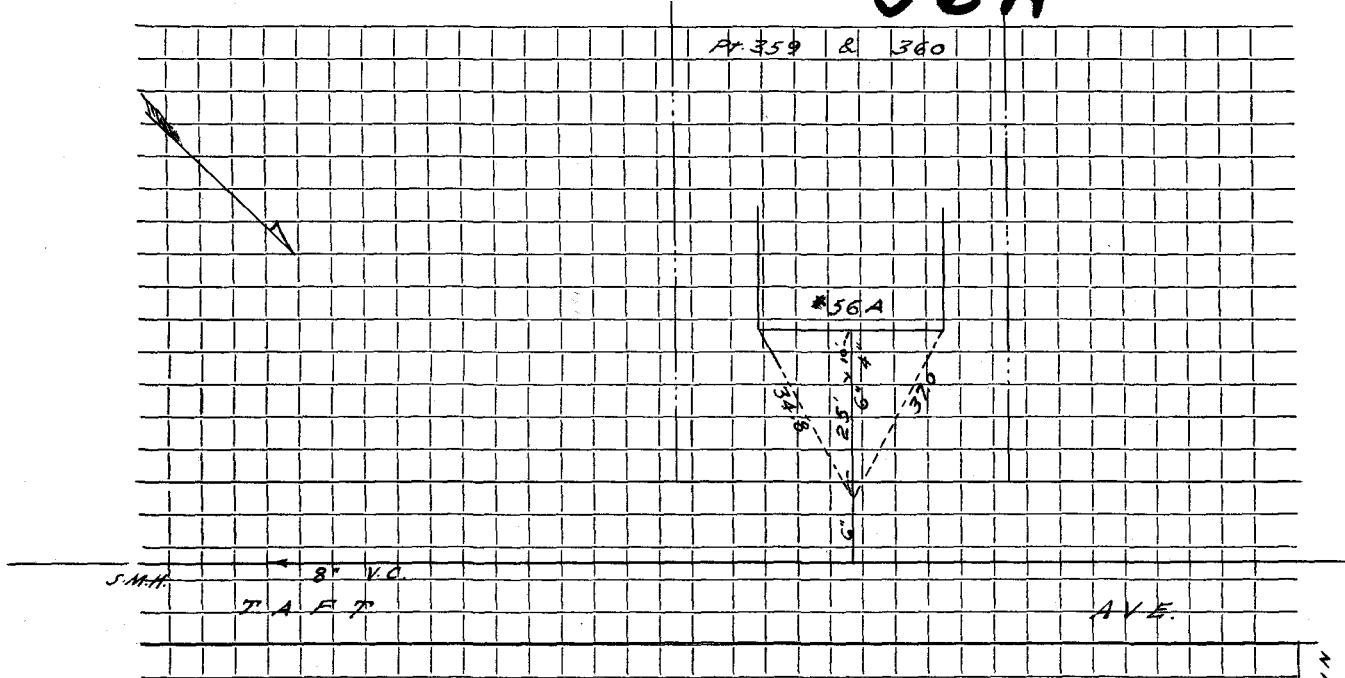

Connection made in Street. Work completed

Remarks:

.....

.....