

Name Donna Realty Trust

Service No. 127

Address 56 Taft Avenue

56 Taft Ave.

Location

Kind of Pipe

Size 6"

Size of Main 8"

Repair—Renewal—New Service W.O.#5603 Valeri #836


Location AUG 5 1968

Date	Material	Amount	Total	Date	Amount
10-16-67	25' 6" Transite pipe			11-4-68	150 00
	10' 4" Cast Iron pipe			8-5-68	12 64
10-13-67	Labor 57.44				162 64
10-20-67	" 23.62	81.06			
	10% O.H.	8.11	89.17		
	20' 6" Transite pipe @88		17.60		
	1 6" Cap		1.63		
	$\frac{1}{4}$ bag cement @1.55		.39		
	1 ton Cold Patch		5.50		
	2 ton Hot Top @5.80		11.60		
	3 $\frac{1}{2}$ hrs. Trucking @3.00		10.50		
	2 $\frac{1}{2}$ hrs. Town Shovel @6.50		16.25		
	1 hr. Loader		4.00		
	$\frac{1}{2}$ hr. Compressor @5.00		2.50		
	$\frac{1}{2}$ hr. Roller & trailer		3.50		
			162.64		

DATE _____

TOWN OF LEXINGTON — BOARD OF PUBLIC WORKS
SEWER DIVISION

Sketch of Service Here **56**

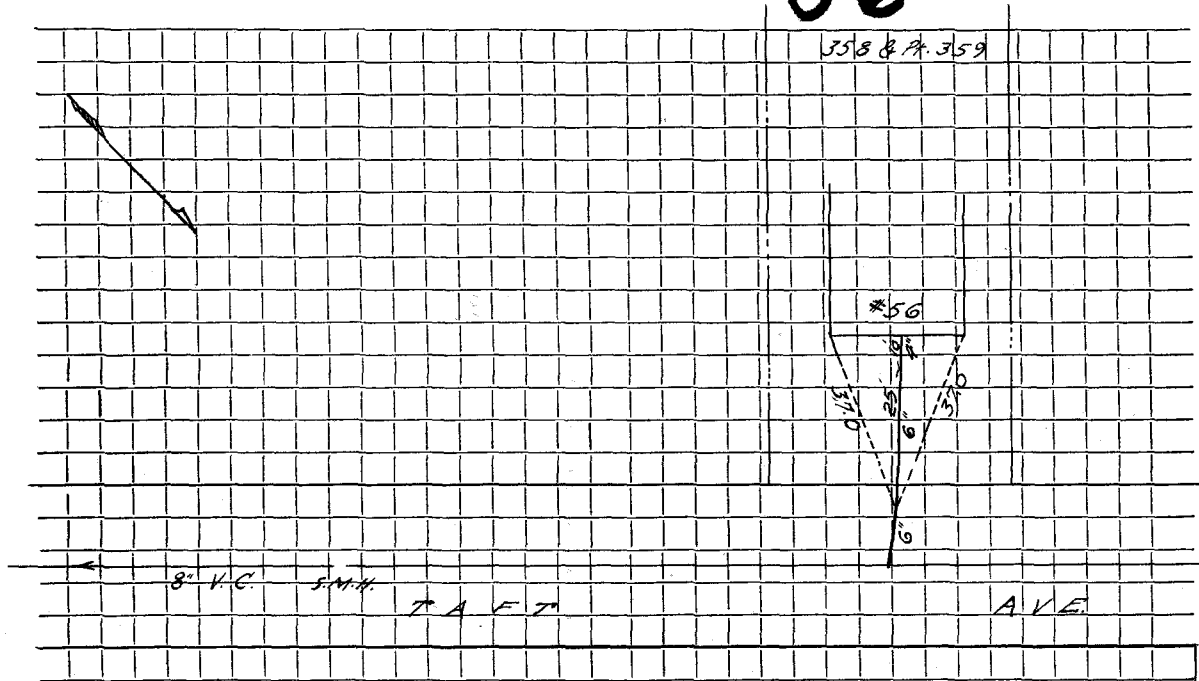

Connection made in Street. Work completed

Remarks:
.....
.....