

Name James Irwin

Service No. 199

Address 58 Taft Avenue

*Conn. 12-31-55*

Location

Kind of Pipe

Size 6"

Size of Main 8"

~~Repair - Renewal~~ - New Service

Location

Date	Material	Amount	Total	Date	Amount
12/7/55	Labor	28 62		9-29-55 Deposited	100 00
	10% overhead	2 86	31 48	3-12-56 Paid	14 80
	40' - 6" sewer pipe @ .50		20 00		114 80
	12 x 3 patching		12 00		
	joint compound		2 10		
	5-2/3 hrs. Littlefield shovel @ 8.50		48 17		
	1 hr. trucking		75		
			114 80		
	Labor			Bill sent 1-10-56	

**TOWN OF LEXINGTON—DEPT. OF PUBLIC WORKS**  
**SEWER DIVISION**

DATE.....

NO. ....

The undersigned applies for the construction of a particular sewer connecting No.....  
Street and hereby agrees to comply with the Rules and Regulations governing the construction and use of Particular  
Sewers, as now or at any future time established by the Board of Selectmen.


Am't of estimate \$.....

Am't Paid \$.....

..... Owner

---

**Sketch of Service Here**

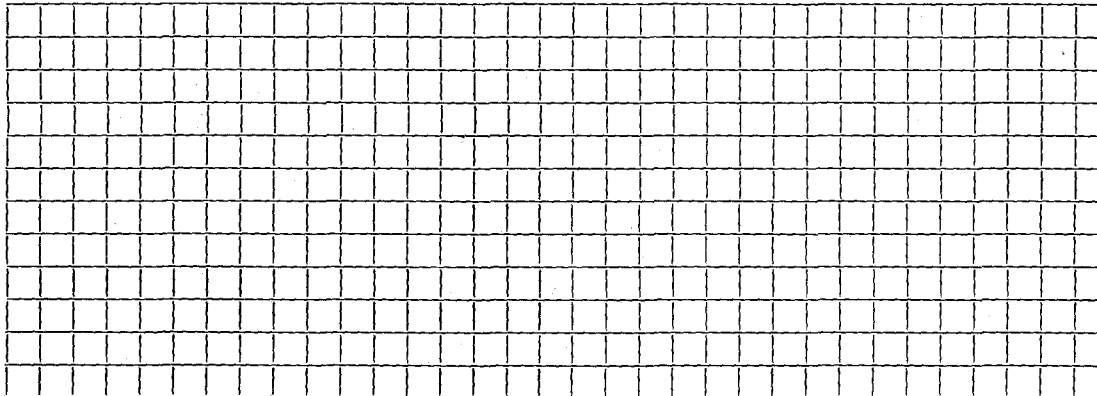

Connection made in..... Street.

Work completed.....19..

Remarks: